

1993

RECORDED

OTTAWA COUNTY REMONUMENTATION  
LAND CORNER RECORDATION CERTIFICATE  
Filing Requirement of Act 74, Mich. P.A. 1970

93 DEC 15 AM 9: 27

For corners in COMMISSION

*Phyllis Alderman*  
REGISTER OF DEEDS  
OTTAWA COUNTY, MI

Ottawa (County)	Located In:	Corner Code #
1. Public Land Survey	T <u>8N</u> R <u>13W</u>	<u>D-7 (S/4, 17)</u> <u>Wright Twp.</u>
	T _____ R _____	_____
	T _____ R _____	_____
	T _____ R _____	_____
2. Property Controlling in Section	S _____ T _____ R _____	_____
	S _____ T _____ R _____	_____
3. Miscellaneous Property in Sec.	S _____ T _____ R _____	_____
	S _____ T _____ R _____	_____
4. Lot No. _____, Recorded Plat _____		
5. Private Claims _____		

Register of Deeds Stamp & File Number

I, Donald W. Schiele, in a field survey on November 16, 19 93, do hereby certify that under requirements of P.A. 74, Michigan P.A. of 1970, the corner points mentioned in lines 1 and 2 above were in conformance with regulations and rules therefore as required in the current manual of survey instructions of the United States Department of the Interior, Bureau of Land Management or by a decree of a Court of Law and/or that the corner points mentioned in lines 3, 4 and 5 above were in conformance with the rules of the Michigan Board of Land Surveyors or by a Decree of a Court of Law; established, re-established, monumented, re-monumented, recovered, found as expressed below:

A	B	C	D	E	F	G	H	I	J	K	L	M
2	6	5	4	3	2	1						
3												
4	7	8	9	10	11	12						
5												
6	18	17	16	15	14	13						
7												
8	19	20	21	22	23	24						
9												
10	30	29	28	27	26	25						
11												
12	31	32	33	34	35	36						
13												

**NOTE: Not more than 4 corners, all in the same town and range, may be recorded on this certificate.**

A. Description of original monument and accessories and/or subsequent restoration:  
D-7 corner common to Sections 17 & 20, Wright Twp.

L.C.R.C. recorded in Liber 2, Page 79, 3-23-73 Iron in Monument Box Fence Post N. 31.75'	L.C.R.C. recorded in Liber 3, Page 270, 6-12-78 1/2" Pipe Wood Post North 31.49' Wood Post N32°W 39.57'
---	---

L.C.R.C. recorded in Liber 5  
Page 358, 12-6-88  
C.I.M.  
Cut off TP Post N 31.51'  
Cut off TP Post NW 39.62'  
Nail in E Face  
Cut off TP Post NNW 129.53'  
Nail in E Face

B. Description of corner evidence found and/or method applied in restoring or reestablishing corner:

D-7 Found Cast Iron Monument inscribed "Section Corner" in Monument Box and accepted as a careful and faithful perpetuation of the position of the original corner.

Found PK nail in SW side of cut off Telephone Pole post	WNW	129.71'
Found Tag # 2442 and double-headed nail in NE side of cut off T.P. post	NW	39.55'
Found Tag # 2442 and double-headed nail in East side of cut off T.P. post	North	31.46'
Found nail in East side of cut off T.P. post	North	31.74'
Found PK nail in North side of 8" Juniper	N73°E	126.43'
Found PK nail in West side of 12" Cherry	S01°E	60.70'

C. Description of monument for corner and accessories established to perpetuate locating the position of the corner:


D-7 Cast Iron Monument inscribed "Section Corner" 6" below surface in Monument Box.

Set Ottawa County Remon Tag & nail in North side of 8" juniper	N73°E	126.49'
Set Ottawa County Remon Tag & nail in West side of 12" Cherry	S01°E	60.63'
Set Ottawa County Remon Tag & nail in South side of 20" Maple	N72°W	167.35'
Set Ottawa County Remon Tag & nail in SW side of cut off T.P. post	N34°W	39.61'
Set Ottawa County Remon Tag & nail in East side of cut off T.P. post	N02°W	31.73'

On Centerline asphalt road East & West  
On Occupation line North & South

Signed by Donald W. Schiele  
Surveyor's Michigan License No. 23517

Date DEC. 6, 1993

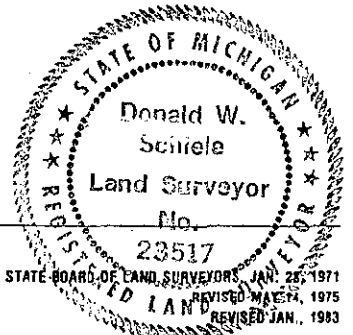

FORM APPROVED BY MICHIGAN STATE BOARD OF LAND SURVEYORS, JAN. 25, 1971  
REVISED MAY 24, 1975  
REVISED JAN., 1993