

**SURVEY & REMONUMENTATION**

APR 25 1995

**COMMISSION**

**OTTAWA COUNTY REMONUMENTATION  
LAND CORNER RECORDATION CERTIFICATE  
Filing Requirement of Act 74, Mich. P.A. 1970**

**RECORDED**

91 DEC -8 PM 12:35

For corners in

| Ottawa<br>(County)                    | Located In:              | Corner Code #                              |
|---------------------------------------|--------------------------|--|
| 1. Public Land Survey                 | T <u>8N</u> R <u>13W</u> | D-11 (N $\frac{1}{4}$ , 32)<br>Wright Twp. |
|                                       | T _____ R _____          | _____                                      |
|                                       | T _____ R _____          | _____                                      |
|                                       | T _____ R _____          | _____                                      |
| 2. Property Controlling<br>in Section | S _____ T _____ R _____  | _____                                      |
|                                       | S _____ T _____ R _____  | _____                                      |
| 3. Miscellaneous<br>Property in Sec.  | S _____ T _____ R _____  | _____                                      |
|                                       | S _____ T _____ R _____  | _____                                      |
| 4. Lot No. _____, Recorded Plat _____ |                          |  |
| 5. Private Claims _____               |                          |  |

*Register of Deeds*  
REGISTER OF DEEDS  
OTTAWA COUNTY, MI

Register of Deeds Stamp & File Number

|    | A  | B  | C  | D  | E  | F  | G | H | I | J | K | L | M |
|----|----|----|----|----|----|----|---|---|---|---|---|---|---|
| 2  | 6  | 5  | 4  | 3  | 2  |    |   |   |   |   |   |   |   |
| 3  |    |    |    |    |    |    |   |   |   |   |   |   |   |
| 4  | 7  | 8  | 9  | 10 | 11 | 12 |   |   |   |   |   |   |   |
| 5  |    |    |    |    |    |    |   |   |   |   |   |   |   |
| 6  | 18 | 17 | 16 | 15 | 14 | 13 |   |   |   |   |   |   |   |
| 7  |    |    |    |    |    |    |   |   |   |   |   |   |   |
| 8  | 19 | 20 | 21 | 22 | 23 | 24 |   |   |   |   |   |   |   |
| 9  |    |    |    |    |    |    |   |   |   |   |   |   |   |
| 10 | 30 | 29 | 28 | 27 | 26 | 25 |   |   |   |   |   |   |   |
| 11 |    |    |    |    |    |    |   |   |   |   |   |   |   |
| 12 | 31 | 32 | 33 | 34 | 35 | 36 |   |   |   |   |   |   |   |
| 13 |    |    |    |    |    |    |   |   |   |   |   |   |   |

I, Donald W. Schiele, in a field survey on November 14, 19 94, do hereby certify that under requirements of P.A. 74, Michigan P.A. of 1970, the corner points mentioned in lines 1 and 2 above were in conformance with regulations and rules therefore as required in the current manual of survey instructions of the United States Department of the Interior, Bureau of Land Management or by a decree of a Court of Law and/or that the corner points mentioned in lines 3, 4 and 5 above were in conformance with the rules of the Michigan Board of Land Surveyors or by a Decree of a Court of Law; established, re-established, monumented, re-monumented, recovered, found as expressed below:

**NOTE: Not more than 4 corners, all in the same town and range, may be recorded on this certificate.**

A. Description of original monument and accessories and/or subsequent restoration:  
D-11  $\frac{1}{4}$  corner common to Sections 29 & 32, Wright Twp.

|                                      |   |  |
|--------------------------------------|---|--|
| Original Government Corner Record:   | L.C.R.C. recorded in Liber 3, Page 180, 9-16-77 | L.C.R.C. recorded in Liber 6, Page 45, 9-11-90 |
| Set qr sec post between Sec. 29 & 32 | Found Pipe Mon. Box N. 37.41' 6" Apple          | Pipe in Monument Box 10" Apple North 37.47'    |
| Post                                 | NW. 83.05' 4" Locust                            | E. end Conc. Culv. SSW 30.25'                  |
| Sugar 12 S21W 5                      |   | W. end Conc. Culv. SW 41.30'                   |
| Beech 6 N15E 20                      |   | 6" Quad. Thornapple NNW 50.40'                 |
| Enoch Hammele, Deputy Surveyor       |   |  |
| Between 9-18 and 9-26, 1838          |   |  |

B. Description of corner evidence found and/or method applied in restoring or reestablishing corner:  
D-11 Found 3/4" i.d. X 12" Iron Pipe, at surface in Monument Box, and accepted as a careful and faithful perpetuation of the position of the original corner.

|   |       |        |
|---|-------|--------|
| Found nail in East side of 12" Apple        | N02°E | 37.58' |
| East end, 12" Concrete Culvert              | S10°W | 30.10' |
| West end, 12" Concrete Culvert              | S55°W | 41.15' |
| Found nail in NE side of 7" Quad Thornapple | N28°W | 50.34' |

*Andrey P. Nedwell*  
P.A. 345 OTTAWA COUNTY


PEER APPROVED 11/21/94

C. Description of monument for corner and accessories established to perpetuate locating the position of the corner:  
D-11 Replaced 3/4" i.d. X 12" Iron Pipe with 3/4" X 24" Steel Bar & Ottawa County Remon Cap, 2 1/2" below surface in Monument Box.

|   |       |         |
|---|-------|---------|
| Set Ottawa County Remon Tag & nail in East side of 12" Apple        | N02°E | 37.60'  |
| Chiselled "X" on East end of 12" Concrete Culvert                   | S10°W | 30.17'  |
| Chiselled "X" on West end of 12" Concrete Culvert                   | S55°W | 40.96'  |
| Set Ottawa County Remon Tag & nail in South side of 13" Aspen       | N70°W | 145.85' |
| Set Ottawa County Remon Tag & nail in NE side of 7" Quad Thornapple | N28°W | 50.60'  |
| On occupation lines North & South                                   |       |         |
| On centerline asphalt road East & West                              |       |         |

Signed by Donald W. Schiele  
Surveyor's Michigan License No. 23517

Date Nov. 18, 1994

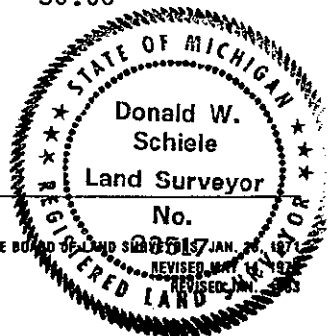

FORM APPROVED BY MICHIGAN STATE BOARD OF LAND SURVEYORS JAN. 24, 1971 REVISED JAN. 1982 REVISED JAN. 1985