

FEB 24 2000

RECORDED

99 OCT 27 PM 1:50

SECTION

OTTAWA COUNTY REMONUMENTATION
LAND CORNER RECORDATION CERTIFICATE
Filing Requirement of Act 74, Mich. P.A. 1970

Lang Schiele
REGISTER OF DEEDS
OTTAWA COUNTY, MI

For corners in


Ottawa (County)	Located in:	Corner Code #
1. Public Land Survey	T 8N R 13W	E-3 (NW, 9)
	T R	Wright Twp.
	T R	
	T R	
2. Property Controlling in Section	S T R	
	S T R	
3. Miscellaneous Property in Sec.	S T R	
	S T R	

Register of Deeds Stamp & File Number

4. Lot No. _____, Recorded Plat _____
5. Private Claims _____

I, Donald W. Schiele, in a field survey on Oct. 7, 1999 do hereby state that under requirements of P.A. 74, Michigan P.A. of 1970, the corner points mentioned in lines 1 and 2 above were in conformance with regulations and rules therefore as required in the current manual of survey instructions of the United States Department of the Interior, Bureau of Land Management or by a decree of a Court of Law and/or that the corner points mentioned in lines 3, 4 and 5 above were in conformance with the rules of the Michigan Board of Land Surveyors or by a Decree of a Court of Law, established, re-established, monumented, recovered, found as expressed below:

NOTE: Not more than 2 corners, all in the same town and range, may be recorded on this certificate.

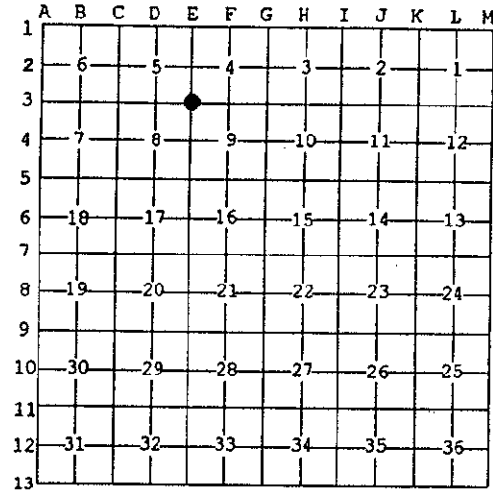


A. Description of original monument and accessories and/or subsequent restoration:
 E-3 Corner common to Sections 4, 5, 8 & 9, Wright Twp.
 Original Government Corner Record: L.C.R.C. recorded in L.1, P.391, 5-11-72 by Dvaid R. Greer:
 Post E-3 Set Iron Pipe
 Ash 9 S23E. 21 Nail in face of Triple 6" Maple N40°W 27.95'
 do 12 N25W. 11 Nail in face of Twin 10" Maple N60°E 27.04'
 Enoch Hammele, Deputy Surveyor, for Nail in face of Twin 16" Maple S30°E 19.48'
 Rasselas Whitcomb, Deputy Surveyor Nail in face of Twin 4" Sassafrass S70°E 57.80'
 Between 9-18 and 9-26, 1838

(SEE REVERSE)

B. Description of corner evidence found and/or method applied in restoring or reestablishing corner:
 E-3 Found Cast Iron Monument inscribed "Ottawa County Section Corner" 6" below surface of gravel road and accepted as a careful and faithful perpetuation of the position of the original corner.
 Face of 10" Twin Stump N49°E 27.2' (E)
 Face of 8" Stump and 8" Dead Tree S64°30'E 57.4' (E)
 7" Stump S59°30'E 43.0' (E)
 Found nail and tag in SE side of 7" Triple Stump N31°W 27.96' (E)
 12" Stump N14°30'W 20.7' (E)

C. Description of monument for corner and accessories established to perpetuate locating the position of the corner:
 E-3 Cast Iron Monument inscribed "Ottawa County Section Corner" 6" below surface of gravel road.
 Set Ottawa County Remon Tag and nail in SE side of 8" Ash N59°30'E 74.80' (E)
 Set Ottawa County Remon Tag and nail in NE side of 6" Ash S56°E 53.33' (E)
 Set Ottawa County Remon Tag and nail in NW side of 6" Maple S37°W 54.06' (E)
 Set Ottawa County Remon Tag and nail in SW side of 8" Maple N65°W 77.82' (E)
 1' of East and West gravel road 1' South

Signed by Donald W. Schiele
Surveyor's Michigan License No. 23517

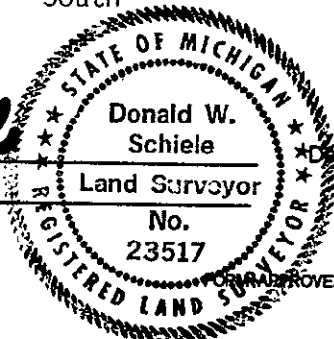

Date Oct. 18, 1999

\$11.00 CORNER
Receipt #61757

Part A., continued:

L.C.R.C. recorded in L.3, P.66, 3-29-76 by John P. Clapp:

E-3 Set cast iron Mon.
16" Maple NW 19.18'
14" twin Maple SE 20.18'

FEB 24 2000

SECTION

L.C.R.C. recorded in L.6, P.102, 1-28-91 by Thomas E. Joiner:

E-3 Found CIM
Cut off 12" Stump NNW 20.46
6" Elm Se 42.65