

**SURVEY & REMONUMENTATION**

RECORDED

APR 24 1995

OTTAWA COUNTY REMONUMENTATION  
**LAND CORNER RECORDATION CERTIFICATE**  
 Filing Requirement of Act 74, Mich. P.A. 1970

94 DEC 15 AM 11:53


*Polycarpus Robinson*  
 REGISTER OF DEEDS  
 OTTAWA COUNTY, MI

For corners **COMMISSION**

<u>Ottawa</u> (County)	Located In:	Corner Code #
1. Public Land Survey	T <u>8N</u> R <u>13W</u>	<u>E-9 (SE, 20)</u> <u>Wright Twp.</u>
	T _____ R _____	_____
	T _____ R _____	_____
2. Property Controlling in Section	S _____ T _____ R _____	_____
	S _____ T _____ R _____	_____
3. Miscellaneous Property in Sec.	S _____ T _____ R _____	_____
	S _____ T _____ R _____	_____
4. Lot No. _____, Recorded Plat _____		
5. Private Claims _____		

Register of Deeds Stamp & File Number

I, Donald W. Schiele, in a field survey on December 1, 1994, do hereby certify that under requirements of P.A. 74, Michigan P.A. of 1970, the corner points mentioned in lines 1 and 2 above were in conformance with regulations and rules therefore as required in the current manual of survey instructions of the United States Department of the Interior, Bureau of Land Management or by a decree of a Court of Law and/or that the corner points mentioned in lines 3, 4 and 5 above were in conformance with the rules of the Michigan Board of Land Surveyors or by a Decree of a Court of Law; established, re-established, monumented, re-monumented, recovered, found as expressed below:

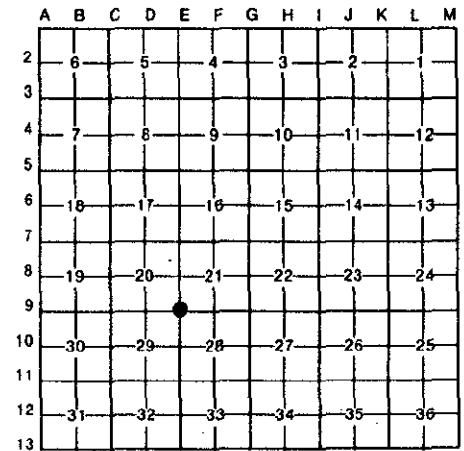

**NOTE: Not more than 4 corners, all in the same town and range, may be recorded on this certificate.**


A. Description of original monument and accessories and/or subsequent restoration:  
 E-9 corner common to Sections 20, 21, 28 & 29, Wright Twp.  
 Original Government L.C.R.C. recorded in Liber 1, Page 811, 12-8-72  
 Corner Record: Beech 10 for cor Sec. 20, 21, 28, 29. Found 1" Iron Pipe  
 10" Beech (no ties taken) P. Pole SE 75.50'  
 Enoch Hammele, Deputy Surveyor T. Pole SW 50.75'  
 Between 9-18 and 9-26, 1838 P. Pole NW 62.65'

L.C.R.C. recorded in Liber 3, Page 15, 12-11-75  
 Found Iron Monument  
 Nail in P. pole NW 63.09'  
 Nail in T. pole SW 51.12'  
 Nail in P. Pole SE 76.20'

(SEE REVERSE)

B. Description of corner evidence found and/or method applied in restoring or reestablishing corner:  
 E-9 Found Cast Iron Monument inscribed "Ottawa County Section Corner", 6" below surface in Monument Box 4" below surface, and accepted as a careful and faithful perpetuation of the position of the original corner.

Found nail in NE side of Power Pole	S32°E	80.35'
West end, 15" Concrete Culvert	S26°30'W	57.75'
Found nail in face of cut-off Telephone Pole	S54°W	50.59'
Found nail in NW side of cut-off Telephone Pole	S54°W	51.04'
Found nail in NE side of Power Pole	N61°W	61.09'

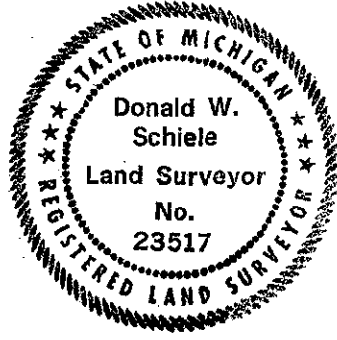

OTTAWA COUNTY  
 PEER APPROVED 12/12/94  
*Wesley P. McDowell*

C. Description of monument for corner and accessories established to perpetuate locating the position of the corner:  
 E-9 Cast Iron Monument inscribed "Ottawa County Section Corner", 6" below surface in Monument Box raised to grade.

Chiselled "X" in North end of 15" Concrete Culvert	N77°E	107.05'
Set Ottawa County Remon Tag & nail in NE side of Power Pole	S32°E	80.33'
Chiselled "X" in West end of 15" Concrete Culvert	S26°30'W	57.61'
Set Ottawa County Remon Tag & nail in NW side of cut-off Telephone Pole	S54°W	51.03'
Set Ottawa County Remon Tag & nail in SW side of Power Pole	N61°W	61.13'

On centerline gravel road to North.  
 Centerline gravel road to South, 1' West.  
 On centerline East & West asphalt road tangents. Centerline of road curve, 0.5' North.

Signed by Donald W. Schiele Date DEC. 12, 1994  
 Surveyor's Michigan License No. 23517

PART A. continued:

L.C.R.C. recorded in Liber 3, Page 56, 3-29-76  
E-9

Set cast iron Mon over stone

Tel pole SSE 91.24'

P. pole WNW 63.21'

C/L W. end 15" concrete culvert SW 57.6'

99.91, 21.00

dim

8538  
# 2000  
# 2000  
# 2000

120 #