

SURVEY & REMONUMENTATION

APR 25 1995

COMMISSION

OTTAWA COUNTY REMONUMENTATION
LAND CORNER RECORDATION CERTIFICATE
Filing Requirement of Act 74, Mich. P.A. 1970

RECORDED

94 DEC -8 PM 12:39

For corners in

<u>Ottawa</u> (County)	Located In:	Corner Code #
1. Public Land Survey	T <u>8N</u> R <u>13W</u>	<u>E-11 (NW, 33)</u> <u>Wright Twp.</u>
	T _____ R _____	_____
	T _____ R _____	_____
	T _____ R _____	_____
2. Property Controlling in Section	S _____ T _____ R _____	_____
	S _____ T _____ R _____	_____
3. Miscellaneous Property in Sec.	S _____ T _____ R _____	_____
	S _____ T _____ R _____	_____
4. Lot No. _____, Recorded Plat _____		
5. Private Claims _____		

Polymnia Robinson
REGISTER OF DEEDS
OTTAWA COUNTY, MI

Register of Deeds Stamp & File Number

I, Donald W. Schiele, in a field survey on October 14, 19 94, do hereby certify that under requirements of P.A. 74, Michigan P.A. of 1970, the corner points mentioned in lines 1 and 2 above were in conformance with regulations and rules therefore as required in the current manual of survey instructions of the United States Department of the Interior, Bureau of Land Management or by a decree of a Court of Law and/or that the corner points mentioned in lines 3, 4 and 5 above were in conformance with the rules of the Michigan Board of Land Surveyors or by a Decree of a Court of Law; established, re-established, monumented, re-monumented, recovered, found as expressed below:

NOTE: Not more than 4 corners, all in the same town and range, may be recorded on this certificate.

A. Description of original monument and accessories and/or subsequent restoration:

E-11 corner common to Sections 28, 29, 32 & 33, Wright Twp.	L.C.R.C. recorded in Liber 1, Page 265, 2-15-72	L.C.R.C. recorded in Liber 3, Page 48, 3-29-76
Original Government Corner Record:	Found Iron	Set cast iron Mon.
Set corner post Sec. 28, 29, 32, 33.	Nail in face of PP NW 54.78'	P. pole NW 55.15'
Post	Nail in face of PP SE 128.61'	C/L St. Sign SE 45.9'
Sugar 12 S 4E 12	Dead End sign NE 59.00'	Dead End Sign NE 59.2'
Do 16 N45E 26	St. sign SE 45.45'	

Enoch Hammele, Deputy Surveyor
Between 9-18 and 9-26, 1838

B. Description of corner evidence found and/or method applied in restoring or reestablishing corner:

E-11 Found Cast Iron Monument inscribed "Ottawa County Section Corner", 3/2" below surface in Monument Box, and accepted as a careful and faithful perpetuation of the position of the original corner.

Centerline Dead End Sign	N15°E	59.5'
Centerline Street Sign	S45°E	46.2'
Nail & Tag # 14091 in face of Power Pole	S31°E	128.52'
Nail & Tag # 14091 in SW side of Power Pole	N44°W	55.09'
Nail & washer in SW side of Power Pole	N44°W	55.09'


P.A. 345 OTTAWA COUNTY

PEER APPROVED 10/17/94

Andrey P. Nedelko

C. Description of monument for corner and accessories established to perpetuate locating the position of the corner:

E-11 Cast Iron Monument inscribed "Ottawa County Section Corner" 3/2" below surface in Monument Box		
Chiselled "X" in North end of 15" Concrete Culvert	N40°E	37.64'
Set Ottawa County Remon Tag & nail in SW side of Power Pole	S31°E	128.97'
Chiselled "X" in South end of 15" Concrete Culvert	S77°W	124.60'
SE corner, footing to attached garage	N70°30'W	227.54'
Set Ottawa County Remon Tag & nail in SW side of Power Pole	N44°W	55.19'
Centerline gravel road North, 2' West		
Centerline asphalt road East & West, 0.5' North		
On centerline asphalt road South		

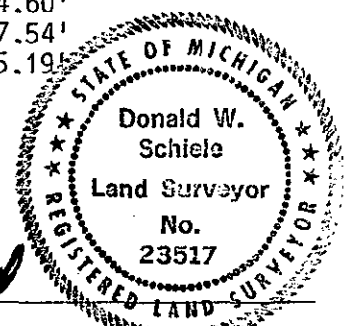

Signed by Donald W. Schiele

Date Oct. 17, 1994

Surveyor's Michigan License No. 23517

FORM APPROVED BY MICHIGAN STATE BOARD OF LAND SURVEYORS, JAN. 28, 1971
REVISED MAY 14, 1975
REVISED JAN., 1983