

SURVEY & REMONUMENTATION

APR 24 1995

OTTAWA COUNTY REMONUMENTATION
LAND CORNER RECORDATION CERTIFICATE
 Filing Requirement of Act 74, Mich. P.A. 1970

RECORDED

94 DEC 15 AM 11:47


For corner **COMMISSION**

Richard C. Williams
 REGISTER OF DEEDS
 OTTAWA COUNTY, MI

<u>Ottawa</u> (County)	Located In:	Corner Code #
1. Public Land Survey	T <u>8N</u> R <u>13W</u>	F-3 (N $\frac{1}{4}$, 9) Wright Twp.
	T _____ R _____	_____
	T _____ R _____	_____
	T _____ R _____	_____
2. Property Controlling in Section	S _____ T _____ R _____	_____
	S _____ T _____ R _____	_____
3. Miscellaneous Property in Sec.	S _____ T _____ R _____	_____
	S _____ T _____ R _____	_____

Register of Deeds Stamp & File Number

4. Lot No. _____, Recorded Plat _____
 5. Private Claims _____

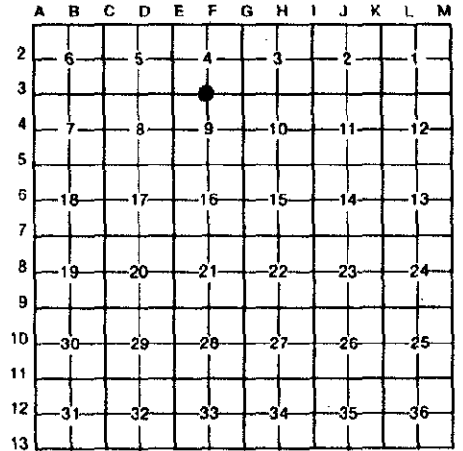

I, Donald W. Schiele, in a field survey on December 7, 19 94
 do hereby certify that under requirements of P.A. 74, Michigan P.A. of 1970, the corner points mentioned in lines 1 and 2 above were in conformance with regulations and rules therefore as required in the current manual of survey instructions of the United States Department of the Interior, Bureau of Land Management or by a decree of a Court of Law and/or that the corner points mentioned in lines 3, 4 and 5 above were in conformance with the rules of the Michigan Board of Land Surveyors or by a Decree of a Court of Law; established, re-established, monumented, re-monumented, recovered, found as expressed below:

NOTE: Not more than 4 corners, all in the same town and range, may be recorded on this certificate.

A. Description of original monument and accessories and/or subsequent restoration:
 F-3 $\frac{1}{4}$ corner common to Sections 4 & 9, Wright Twp.

Original Government Corner Record: Set qr sec post between Sec. 4 & 9 Post Elm 10 S81W 9 Beech 6 N62E 9 Enoch Hammele, Deputy Surveyor Between 9-18 and 9-26, 1838	L.C.R.C. recorded in Liber 1, Page 391, 5-11-72 Set Cast Iron Monument from old Co. notes, inscribed "Ottawa Co. Sec. Cor." Nail in face of 12" Maple North 38.22' Nail in face of 40" Stump S45°W 64.30' Nail in face of Power Pole N45°W 152.81' Nail in face of 6" Ash N30°E 22.62' Tel. Line Marker S30°W 53.72'
--	---

B. Description of corner evidence found and/or method applied in restoring or reestablishing corner:

F-3 Found Cast Iron Monument inscribed "Ottawa County Section Corner", 4" below surface, and accepted as a careful and faithful perpetuation of the position of the original corner.	
Centerline 16" Ash	N39°E 22.9'
Centerline Telephone Pedestal	S31°W 53.5'
Found nail & Tag # 16042 in SE side of Power Pole	N52°W 152.79'

P.A. 345 OTTAWA COUNTY
 PEER APPROVED 12/12/94

Richard P. Newell



C. Description of monument for corner and accessories established to perpetuate locating the position of the corner:

F-3 Cast Iron Monument inscribed "Ottawa County Section Corner", 4" below surface.	
Set Ottawa County Remon Tag & nail in SE side of 10" Cherry	N12°E 29.15'
Set Ottawa County Remon Tag & nail in SE side of 11" Twin Ash	N67°E 74.09'
Set Ottawa County Remon Tag & nail in SW side of 15" Twin Cottonwood	S26°30'E 141.93'
Set Ottawa County Remon Tag & nail in SW side of Power Pole	N52°W 153.13'
Occupation line to North, 4' West	
Centerline gravel road South, 2' East	
Centerline gravel road East & West, 3' South	

Signed by Donald W. Schiele Date Dec. 12, 1994

Surveyor's Michigan License No. 23517