

SURVEY & REMONUMENTATION

APR 24 1995

OTTAWA COUNTY REMONUMENTATION
LAND CORNER RECORDATION CERTIFICATE
 Filing Requirement of Act 74, Mich. P.A. 1970

RECORDED

94 DEC 14 AM 9:40

For corners in
Ottawa **COMMISSION**
 (County)


Located In: Corner Code #

Edythe Robinson
 REGISTER OF DEEDS
 OTTAWA COUNTY, MI

1. Public Land Survey	T 8N R 13W	F-5 (N $\frac{1}{4}$, 16)
	T ___ R ___	Wright Twp.
	T ___ R ___	
	T ___ R ___	
2. Property Controlling in Section	S ___ T ___ R ___	
	S ___ T ___ R ___	
3. Miscellaneous Property in Sec.	S ___ T ___ R ___	
	S ___ T ___ R ___	

Register of Deeds Stamp & File Number

4. Lot No. _____, Recorded Plat _____
 5. Private Claims _____

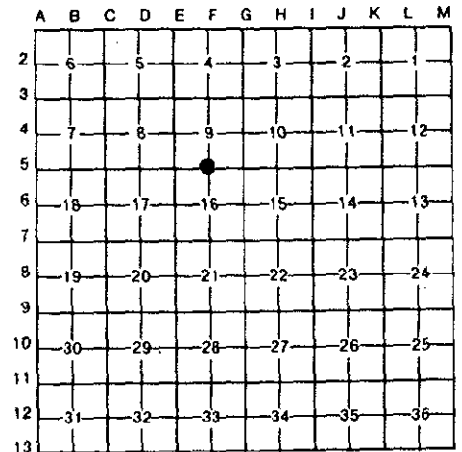

I, Donald W. Schiele, in a field survey on December 8, 19 94, do hereby certify that under requirements of P.A. 74, Michigan P.A. of 1970, the corner points mentioned in lines 1 and 2 above were in conformance with regulations and rules therefore as required in the current manual of survey instructions of the United States Department of the Interior, Bureau of Land Management or by a decree of a Court of Law and/or that the corner points mentioned in lines 3, 4 and 5 above were in conformance with the rules of the Michigan Board of Land Surveyors or by a Decree of a Court of Law; established, re-established, monumented, re-monumented, recovered, found as expressed below:

NOTE: Not more than 4 corners, all in the same town and range, may be recorded on this certificate.

A. Description of original monument and accessories and/or subsequent restoration:
 F-5 $\frac{1}{4}$ corner common to Sections 9 & 16, Wright Twp.

Original Government Corner Record:	L.C.R.C. recorded in Liber 1, Page 391, 5-11-72
Set qr sec post between Sec. 9 & 16	Found Iron Bar from old Co. ties
Post	NE cor. Porch SE 83.73'
Ironwood 10 N53E 14	NW cor. Hse. S5°E 66.90'
Do 8 S84W 34	C/L Mich Bell Tel. Box NW 51.61'
Enoch Hammele, Deputy Surveyor	St. Sign South 21.34'
Between 9-18 and 9-26, 1838	Nail in face of C/L Fence Post South 24.84'
	Nail in face of 20" Sassafrass SE 42.53'

L.C.R.C. recorded in
 Liber 3, Page 62, 3-29-76
 Set cast iron Mon.
 20" Walnut SE 43.45'
 C/L St. Sign S 21.37'
 P. pole S 41.55'

B. Description of corner evidence found and/or method applied in restoring or reestablishing corner:
 F-5 Found Cast Iron Monument inscribed "Ottawa County Section Corner", 8" below surface, and accepted as a careful and faithful perpetuation of the position of the original corner.

Found nail & washer in SW side of 32" Walnut	S43°E	43.41'
Found nail in East side of Power Pole	S03°W	41.52'
Centerline Street Sign	S07°W	21.41'
Found PK nail in SE side of Power Pole	S69°30'W	107.54'
Found nail in SE side of Power Pole	S69°30'W	107.67'
Centerline GTE Telephone Pedestal	N42°W	51.7'



Maday P. Nedewell

PA. 345 OTTAWA COUNTY
 PEER APPROVED 12/12/94

C. Description of monument for corner and accessories established to perpetuate locating the position of the corner:
 F-5 Cast Iron Monument inscribed "Ottawa County Section Corner", 8" below surface.

Set Ottawa County Remon Tag & nail in NE side of Power Pole	S66°30'E	179.38'
Set Ottawa County Remon Tag & nail in NE side of 32" Walnut	S43°E	43.53'
Set Ottawa County Remon Tag & nail in East side of Power Pole	S03°W	41.74'
Set Ottawa County Remon Tag & nail in NW side of Power Pole	S69°30'W	107.58'
Centerline Bolt on top of GTE Telephone Pedestal	N42°W	51.73'

On centerline gravel road North
 On occupation line to South
 Centerline gravel road East & West, 2' North

Signed by Donald W. Schiele Date DEC. 12, 1994
 Surveyor's Michigan License No. 23517