

# SURVEY & REMONUMENTATION

APR 25 1995

OTTAWA COUNTY REMONUMENTATION  
LAND CORNER RECORDATION CERTIFICATE  
Filing Requirement of Act 74, Mich. P.A. 1970

RECORDED

94 DEC -8 PM 12:39

COMMISSION

For corners in

Ottawa  
(County)

Located In:

Corner Code #

- |                                    |   |   |    |   |     |                             |
|------------------------------------|---|---|----|---|-----|-----------------------------|
| 1. Public Land Survey              |   | T | 8N | R | 13W | F-11 (N $\frac{1}{4}$ , 33) |
|                                    |   | T |    | R |     | Wright Twp.                 |
|                                    |   | T |    | R |     |                             |
|                                    |   | T |    | R |     |                             |
| 2. Property Controlling in Section | S |   | T  |   | R   |                             |
|                                    | S |   | T  |   | R   |                             |
| 3. Miscellaneous Property in Sec.  | S |   | T  |   | R   |                             |
|                                    | S |   | T  |   | R   |                             |

*Robert L. Coleman*  
REGISTER OF DEEDS  
OTTAWA COUNTY, MI

Register of Deeds Stamp & File Number

4. Lot No. \_\_\_\_\_, Recorded Plat \_\_\_\_\_  
5. Private Claims \_\_\_\_\_

	A	B	C	D	E	F	G	H	I	J	K	L	M
2	6	5	4	3	2	1							
3													
4	7	8	9	10	11	12							
5													
6	18	17	16	15	14	13							
7													
8	19	20	21	22	23	24							
9													
10	30	29	28	27	26	25							
11													
12	31	32	33	34	35	36							
13													

Donald W. Schiele, in a field survey on October 14, 1994, do hereby certify that under requirements of P.A. 74, Michigan P.A. of 1970, the corner points mentioned in lines 1 and 2 above were in conformance with regulations and rules therefore as required in the current manual of survey instructions of the United States Department of the Interior, Bureau of Land Management or by a decree of a Court of Law and/or that the corner points mentioned in lines 3, 4 and 5 above were in conformance with the rules of the Michigan Board of Land Surveyors or by a Decree of a Court of Law; established, re-established, monumented, re-monumented, recovered, found as expressed below:

**NOTE: Not more than 4 corners, all in the same town and range, may be recorded on this certificate.**

**A. Description of original monument and accessories and/or subsequent restoration:**

F-11  $\frac{1}{4}$  corner common to Sections 28 & 33, Wright Twp.  
L.C.R.C. recorded in Liber 1, Page 265, 2-15-72  
Original Government Corner Record: Found R.R. Spike  
Set qr sec post between Sec. 28 & 33 Post  
Beech 14 N 6W 19  
Sugar 6 S85W 21  
Nail in face of 8" Poplar NW 71.49'  
S. edge E.-bound lane 1-96 North 136.41'  
Rd. Sign (South leg) NE 88.12'

L.C.R.C. recorded in Liber 3, Page 48, 3-29-76  
Set cast iron Mon.  
Twin 4" Elm SSW 38.7'  
6" Poplar NW 71.75'  
6" Elm NNE 63.3'


**B. Description of corner evidence found and/or method applied in restoring or reestablishing corner:**

F-11 Found Cast Iron Monument inscribed "Ottawa County Section Corner", 3" below surface in Monument Box, and accepted as a careful and faithful perpetuation of the position of the original corner.  
South edge of Eastbound lane (not shoulder), I-96 North 136.8'  
Centerline 16" Elm N12°E 63.5'  
Centerline 12" Twin Elm S08°W 39.0'  
Centerline 18" Poplar N33°W 71.8'

**PA. 345 OTTAWA COUNTY**  
**PEER APPROVED** 10/17/94  
*Robert P. Hedden*

**C. Description of monument for corner and accessories established to perpetuate locating the position of the corner:**

F-11 Cast Iron Monument inscribed "Ottawa County Section Corner" 3" below surface in Monument Box.  
Set Ottawa County Remon Tag & nail in East side of 16" Elm N12°E 63.42'  
Set Ottawa County Remon Tag & nail in West side of 12" Twin Elm S08°W 39.69'  
Set Ottawa County Remon Tag & nail in West side of 9" Elm S56°W 53.32'  
Set Ottawa County Remon Tag & nail in SW side of 16" Poplar N33°30'W 64.66'  
Centerline, asphalt road tangent to West is 2.5' North  
Centerline East & West asphalt road curve is 1.5' South  
On centerline occupation line to the South

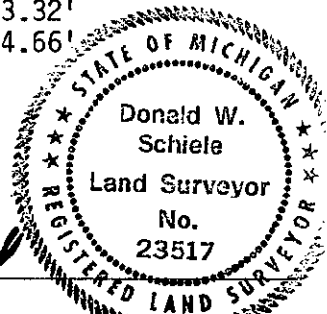

Signed by Donald W. Schiele Date Oct. 17, 1994  
Surveyor's Michigan License No. 23517