

SURVEY & REMONUMENTATION

APR 24 1995

OTTAWA COUNTY REMONUMENTATION
LAND CORNER RECORDATION CERTIFICATE
 Filing Requirement of Act 74, Mich. P.A. 1970

RECORDED

94 DEC 14 AM 9:40


For corners in **COMMISSION**

Phyllis Williams
 REGISTER OF DEEDS
 OTTAWA COUNTY, MI

Ottawa (County)	Located In:	Corner Code #
1. Public Land Survey	T <u>8N</u> R <u>13W</u>	G-3 (NW, 10) Wright Twp.
	T _____ R _____	_____
	T _____ R _____	_____
	T _____ R _____	_____
2. Property Controlling in Section	S _____ T _____ R _____	_____
	S _____ T _____ R _____	_____
3. Miscellaneous Property in Sec.	S _____ T _____ R _____	_____
	S _____ T _____ R _____	_____
4. Lot No. _____, Recorded Plat _____		
5. Private Claims _____		

Register of Deeds Stamp & File Number

I, Donald W. Schiele, in a field survey on December 8, 19 94, do hereby certify that under requirements of P.A. 74, Michigan P.A. of 1970, the corner points mentioned in lines 1 and 2 above were in conformance with regulations and rules therefore as required in the current manual of survey instructions of the United States Department of the Interior, Bureau of Land Management or by a decree of a Court of Law and/or that the corner points mentioned in lines 3, 4 and 5 above were in conformance with the rules of the Michigan Board of Land Surveyors or by a Decree of a Court of Law; established, re-established, monumented, re-monumented, recovered, found as expressed below:

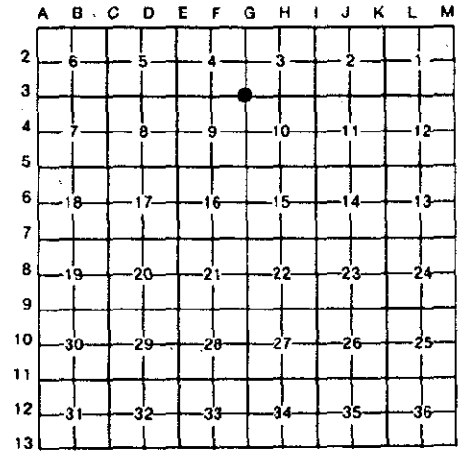

NOTE: Not more than 4 corners, all in the same town and range, may be recorded on this certificate.

A. Description of original monument and accessories and/or subsequent restoration:
 G-3 corner common to Sections 3, 4, 9 & 10, Wright Twp.

Original Government Corner Record:	L.C.R.C. recorded in Liber 6, Page 98, 1-28-91	
Set corner post Sec. 3, 4, 9, 10	Set CIM	
Post	12" Twin Poplar	SE 42.73'
Sugar 20 S 1E 11	6" Poplar	ENE 36.52'
Beech 8 N26W 10	5" Elm	NW 52.02'
Enoch Hammele, Deputy Surveyor	Centerline Stop Sign	53.40'
Between 9-18 and 9-26, 1838		

B. Description of corner evidence found and/or method applied in restoring or reestablishing corner:

G-3 Found Cast Iron Monument wrongly inscribed "Quarter Corner", 2" below surface in Monument Box, and accepted as a careful and faithful perpetuation of the position of the original corner.

Centerline 14" Stump	N73°30'E	36.3'
Centerline 25" Stump	S67°E	43.0'
Centerline Stop Sign	S76°W	53.5'
Centerline 6" Stump	N52°W	52.3'

P.A. 345 OTTAWA COUNTY
PEER APPROVED 12/12/94

Harold D. Newell

C. Description of monument for corner and accessories established to perpetuate locating the position of the corner:

G-3 Cast Iron Monument wrongly inscribed "Quarter Corner", 2" below surface in Monument Box.

Set Ottawa County Remon Tag & nail in West side of Telephone Pole	N08°30'E	219.66' (E)
Set Ottawa County Remon Tag & nail in SW side of Power Pole	S17°E	106.47' (E)
Set Ottawa County Remon Tag & nail in NW side of Power Pole	S63°30'W	195.12' (E)
Set Ottawa County Remon Tag & nail in South side of 18" Elm	N81°30'W	298.79' (E)
Centerline asphalt road North & South, 1.2' West		
On occupation line to East		
On centerline gravel road West		

Signed by Donald W. Schiele Date Dec. 13, 1994
 Surveyor's Michigan License No. 23517

