

**SURVEY &  
REMONUMENTATION**

DEC 01 1993

**OTTAWA COUNTY REMONUMENTATION  
LAND CORNER RECORDATION CERTIFICATE  
Filing Requirement of Act 74, Mich. P.A. 1970**

RECORDED

93 NOV 11 AM 11:54

**COMMISSION**

For corners in

*Phyllis Chubbman*  
REGISTER OF DEEDS  
OTTAWA COUNTY, MI

Ottawa (County)	Located In:	Corner Code #
1. Public Land Survey	T <u>8N</u> R <u>13W</u>	G-6 (W 1/4, 15) Wright Twp.
	T _____ R _____	_____
	T _____ R _____	_____
	T _____ R _____	_____
2. Property Controlling in Section	S _____ T _____ R _____	_____
	S _____ T _____ R _____	_____
3. Miscellaneous Property in Sec.	S _____ T _____ R _____	_____
	S _____ T _____ R _____	_____

Register of Deeds Stamp & File Number

4. Lot No. \_\_\_\_\_, Recorded Plat \_\_\_\_\_  
5. Private Claims \_\_\_\_\_

	A	B	C	D	E	F	G	H	I	J	K	L	M
2	6		5		4		3		2		1		
3													
4	7		8		9		10		11		12		
5													
6	18		17		16		15		14		13		
7													
8	19		20		21		22		23		24		
9													
10	30		29		28		27		26		25		
11													
12	31		32		33		34		35		36		
13													

I, Donald W. Schiele, in a field survey on November 3, 19 93, do hereby certify that under requirements of P.A. 74, Michigan P.A. of 1970, the corner points mentioned in lines 1 and 2 above were in conformance with regulations and rules therefore as required in the current manual of survey instructions of the United States Department of the Interior, Bureau of Land Management or by a decree of a Court of Law and/or that the corner points mentioned in lines 3, 4 and 5 above were in conformance with the rules of the Michigan Board of Land Surveyors or by a Decree of a Court of Law; established, re-established, monumented, re-monumented, recovered, found as expressed below:

**NOTE: Not more than 4 corners, all in the same town and range, may be recorded on this certificate.**

**A. Description of original monument and accessories and/or subsequent restoration:**

G-6 corner common to Sections 15 and 16 Wright Twp.  
L.C.R.C. recorded in Liber 1, Page 393, 5-11-72.  
Iron Pipe on Fence Line to East in CL of Road  
Nail in Face of 12" Ash NE. 70.92'  
Nail in Face of P.P. East 73.87'  
Nail in Face of 6" Maple NW. 93.33'

**B. Description of corner evidence found and/or method applied in restoring or reestablishing corner:**


G-6 Found 3/4" Pipe in Monument Box in Centerline of Road on Occupation Line to East, and accepted as a careful and faithful perpetuation of the position of the original corner.  
Found Tag # 16042 & nail in West side of Power Pole East 73.80'  
Centerline 24" Maple NW 94.2'

**C. Description of monument for corner and accessories established to perpetuate locating the position of the corner:**

G-6 Set 3/4" X 24" solid bar with Ottawa County Remon Cap in Monument Box in place of 3/4" Pipe.  
Set Ottawa County Remon Tag & nail in West side of Power Pole N17°E 222.56'  
Set Ottawa County Remon Tag & nail in SE side of 8" Triple Ash N60°E 58.65'  
Set Ottawa County Remon Tag & nail in South side of Power Pole S88°E 74.22'  
Set Ottawa County Remon Tag & nail in NE side of 24" Maple N34°W 93.61'  
On Centerline asphalt road North and South  
On Occupation Line East

Signed by Donald W. Schiele  
Surveyor's Michigan License No. 23517

Date Nov. 8, 1993

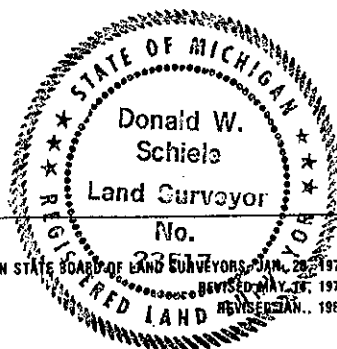

FORM APPROVED BY MICHIGAN STATE BOARD OF LAND SURVEYORS, JAN. 28, 1971  
REVISED MAY 16, 1971  
REVISION JAN., 1991