SURVEY &
REMONUMENTATION

NOV 1 0 1993

COMMISSION

OTTAWA COUNTY REMONUMENTATION
LAND CORNER RECORDATION CERTIFICATE
Filing Requirement of Act 74, Mich. P.A. 1970

RECORDED
1993 SEP 29 PM 3: 14
Phyllis Adams
REGISTER OF DEEDS
OTTAWA COUNTY, MI

Register of Deeds Stamp & File Number

For corners in
Ottawa
(County)

	Located In:	Corner Code #
1. Public Land Survey	T 8N R 13W	G-9 (SW, 22)
	T ___ R ___	Wright Twp.
	T ___ R ___	
	T ___ R ___	
2. Property Controlling	S ___ T ___ R ___	
in Section	S ___ T ___ R ___	
3. Miscellaneous	S ___ T ___ R ___	
Property in Sec.	S ___ T ___ R ___	

4. Lot No. _____ , Recorded Plat _____
5. Private Claims _____

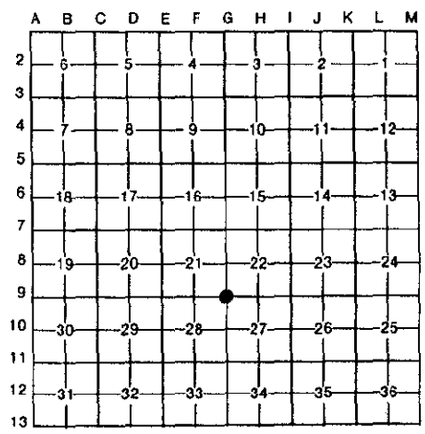

I, Donald W. Schiele, in a field survey on Sept. 18, 19 93, do hereby certify that under requirements of P.A. 74, Michigan P.A. of 1970, the corner points mentioned in lines 1 and 2 above were in conformance with regulations and rules therefore as required in the current manual of survey instructions of the United States Department of the Interior, Bureau of Land Management or by a decree of a Court of Law and/or that the corner points mentioned in lines 3, 4 and 5 above were in conformance with the rules of the Michigan Board of Land Surveyors or by a Decree of a Court of Law; established, re-established, monumented, re-monumented, recovered, found as expressed below:

NOTE: Not more than 4 corners, all in the same town and range, may be recorded on this certificate.

A. Description of original monument and accessories and/or subsequent restoration:

G-9 corner common to Sections 21, 22, 27 and 28 Wright Twp.

T.C.R.C. recorded in Liber 1, Page 811			L.C.R.C. recorded in Liber 3, Page 54		
Steel Bar			C.I.M.		
CL St. Sign	SE.	45.52'	24" Maple	ESE.	131.85'
T. Pole	SE.	62.28'	Tel.Pole	NNW.	139.50'
P. Pole	SW.	61.45'	P. Pole	SW.	61.30'
			CL St. Sign	SE.	45.50'

B. Description of corner evidence found and/or method applied in restoring or reestablishing corner:

G-9
Found broken C.I.M. in Monument Box and accepted as a careful and faithful perpetuation of the position of the original corner.

CL 32" Maple	ESE	131.8'
CL Street Sign	SE	45.25'
Found PK nail in East side of Telephone Pole	SW	61.25'
Found PK nail in NW side of Telephone Pole	SW	61.38'
Found nail in West side of Telephone Pole	NNW	139.49'

C. Description of monument for corner and accessories established to perpetuate locating the position of the corner:

G-9
Cemented 2" dia. Aluminum Ottawa Co. Re-mon. Marker #21272 on 7" long 3/4" dia. Steel Bar in Monument Box over C.I.M.

Set nail and Ottawa Co. re-mon. tag in SE side of 10" Cherry		N63°E 100.00'
Set nail and Ottawa Co. re-mon. tag in North side of 32" Maple		S77°E 131.89'
Set nail and Ottawa Co. re-mon. tag in SE side of Telephone Pole		S33°W 61.35'
Set nail and Ottawa Co. re-mon. tag in East side of Telephone Pole		N13°W 139.49'
CL North and South asphalt road	East	1'
CL East and West asphalt road	North	1'

STATE OF MICHIGAN
Donald W. Schiele
Land Surveyor
No. 23517
REGISTERED LAND SURVEYOR

Signed by Donald W. Schiele Date SEPT. 20, 1993

Surveyor's Michigan License No. 23517

FORM APPROVED BY MICHIGAN STATE BOARD OF LAND SURVEYORS JAN. 26, 1971
REVISED MAY 14, 1975
REVISED JAN. 1983