

SURVEY & REMONUMENTATION

APR 24 1995

**OTTAWA COUNTY REMONUMENTATION
LAND CORNER RECORDATION CERTIFICATE
Filing Requirement of Act 74, Mich. P.A. 1970**

RECORDED

94 DEC 15 AM 11:46

For corner **COMMISSION**

D. W. Schiele
REGISTER OF DEEDS
OTTAWA COUNTY, MI

Ottawa (County)	Located In:	Corner Code #
1. Public Land Survey	T <u>8N</u> R <u>13W</u>	<u>G-13 (SE, 33)</u> <u>Wright Twp.</u>
	T _____ R _____	_____
	T _____ R _____	_____
	T _____ R _____	_____
2. Property Controlling in Section	S _____ T _____ R _____	_____
	S _____ T _____ R _____	_____
3. Miscellaneous Property in Sec.	S _____ T _____ R _____	_____
	S _____ T _____ R _____	_____

Register of Deeds Stamp & File Number

4. Lot No. _____, Recorded Plat _____
5. Private Claims _____

	A	B	C	D	E	F	G	H	I	J	K	L	M
2	6	5	4	3	2	1							
3													
4	7	8	9	10	11	12							
5													
6	18	17	16	15	14	13							
7													
8	19	20	21	22	23	24							
9													
10	30	29	28	27	26	25							
11													
12	31	32	33	34	35	36							
13													

I, Donald W. Schiele, in a field survey on December 3, 19 94
do hereby certify that under requirements of P.A. 74, Michigan P.A. of 1970, the corner points mentioned in lines 1 and 2 above were in conformance with regulations and rules therefore as required in the current manual of survey instructions of the United States Department of the Interior, Bureau of Land Management or by a decree of a Court of Law and/or that the corner points mentioned in lines 3, 4 and 5 above were in conformance with the rules of the Michigan Board of Land Surveyors or by a Decree of a Court of Law; established, re-established, monumented, re-monumented, recovered, found as expressed below:

NOTE: Not more than 4 corners, all in the same town and range, may be recorded on this certificate.


A. Description of original monument and accessories and/or subsequent restoration:
G-13 SE corner of Section 33 & SW corner of Section 34, Wright Twp.
Original Government Corner Record: L.C.R.C. recorded in Liber 6, Page 24, 1-3-90
Set corner post of Sec. 33 and 34 Set CIM
Post NE cor 4-7-13 W 208.58'
Beech 12 N55E 48 18" Maple NW 79.89'
Do 20 N56W 64 30" Oak WNW 86.08'
Noah Brookfield, Deputy Surveyor 4" Cedar NE 77.57'
April 12, 1837

B. Description of corner evidence found and/or method applied in restoring or reestablishing corner:
G-13 Found Cast Iron Monument inscribed "Section Corner", 1-3/4" below surface, and accepted as a careful and faithful perpetuation of the position of the original corner.
Found PK nail in South side of 5" Juniper N38°E 77.60'
Cast Iron Monument West 208.60'
Found PK nail & tag in East side of 30" Oak N67°W 85.98'
Centerline 18" stump N31°W 80.3'

PA. 345 OTTAWA COUNTY
PEER APPROVED 12/12/94

Maday D. Redwood

C. Description of monument for corner and accessories established to perpetuate locating the position of the corner:
G-13 Cast Iron Monument inscribed "Section Corner", 1-3/4" below surface in Monument Box.
Set Ottawa County Remon Tag & nail in SE side of 5" Juniper N38°E 77.76'
NE corner, garage foundation to House # 2416 S10°30'W 104.12'
Cast Iron Monument West 208.60'
Set Ottawa County Remon Tag & nail in SW side of 30" Oak N67°W 87.42'
Set Ottawa County Remon Tag & nail in NE side of 15" Maple N38°W 74.26'
On centerline asphalt roads North, East & West

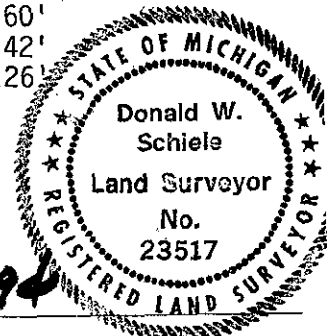

Signed by Donald W. Schiele

Date DEC. 12, 1994

Surveyor's Michigan License No. 23517