

SURVEY & REMONUMENTATION

NOV 10 1993

COMMISSION

**OTTAWA COUNTY REMONUMENTATION
LAND CORNER RECORDATION CERTIFICATE
Filing Requirement of Act 74, Mich. P.A. 1970**

RECORDED

1993 SEP 29 PM 3:14

For corners in

Ottawa (County) Located In: _____ Corner Code ## _____

1. Public Land Survey T 8N R 13W H-9 (S 1/4, 22)
T _____ R _____ Wright Twp.
T _____ R _____
T _____ R _____

2. Property Controlling S _____ T _____ R _____
in Section S _____ T _____ R _____

3. Miscellaneous S _____ T _____ R _____
Property in Sec. S _____ T _____ R _____

4. Lot No. _____, Recorded Plat _____

5. Private Claims _____

Shyllia K. ...
REGISTER OF DEEDS
OTTAWA COUNTY, MI

Register of Deeds Stamp & File Number

I, Donald W. Schiele, in a field survey on Sept. 18, 1993, do hereby certify that under requirements of P.A. 74, Michigan P.A. of 1970, the corner points mentioned in lines 1 and 2 above were in conformance with regulations and rules therefore as required in the current manual of survey instructions of the United States Department of the Interior, Bureau of Land Management or by a decree of a Court of Law and/or that the corner points mentioned in lines 3, 4 and 5 above were in conformance with the rules of the Michigan Board of Land Surveyors or by a Decree of a Court of Law; established, re-established, monumented, re-monumented, recovered, found as expressed below:

A	B	C	D	E	F	G	H	I	J	K	L	M
2	6	5	4	3	2	1						
3												
4	7	8	9	10	11	12						
5												
6	18	17	16	15	14	13						
7												
8	19	20	21	22	23	24						
9												
10	30	29	28	27	26	25						
11												
12	31	32	33	34	35	36						
13												

NOTE: Not more than 4 corners, all in the same town and range, may be recorded on this certificate.

A. Description of original monument and accessories and/or subsequent restoration:

H-9 corner common to Sections 22 and 27 Wright Twp.
L.C.R.C. recorded in Liber 3, Page 54
C.I.M.
P. Pole SW. 63.83'
10" Oak S. 35.67'
CL East end 18" Culvert SW. 38.80'

B. Description of corner evidence found and/or method applied in restoring or reestablishing corner:


H-9
Found C.I.M. Inscribed "Section Corner" in Monument Box and accepted as a careful and faithful perpetuation of the position of the original corner.
Found nail in East side of 17" Oak SSW 35.61'
CL East end 18" Concrete Culvert SW 38.75'
Found PK nail in SE side of Power Pole SW 63.80'

C. Description of monument for corner and accessories established to perpetuate locating the position of the corner:

H-9
Cemented 2" dia. Aluminum Ottawa Co. Re-mon. Marker #21272 on 5" long 3/4" dia. Steel Bar in Monument Box over C.I.M.
Set nail and Ottawa Co. re-mon. tag in SE side of 8" Elm N63°E 105.00'
Set nail and Ottawa Co. re-mon. tag in East side of 17" Oak S7°W 35.62'
Set nail and Ottawa Co. re-mon. tag in SE side of Power Pole S64°W 64.16'
Set nail and Ottawa Co. re-mon. tag in West side of 7" Aspen N17°W 53.48'
CL East and West asphalt road North 0.5'
On occupation line to South±

Signed by Donald W. Schiele
Surveyor's Michigan License No. 23517

Date SEPT. 20, 1993

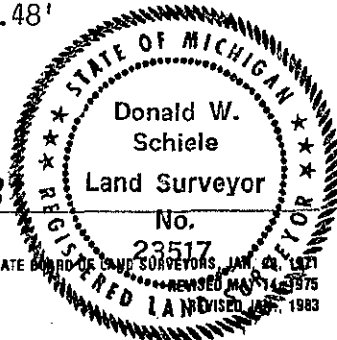

FORM APPROVED BY MICHIGAN STATE BOARD OF LAND SURVEYORS, JAN. 20, 1971