

**SURVEY & RE-MONUMENTATION**

OCT 07 1996

**OTTAWA COUNTY REMONUMENTATION  
LAND CORNER RECORDATION CERTIFICATE  
Filing Requirement of Act 74, Mich. P.A. 1970**

**COMMISSION**

For corners in

|  |                          |   |
|--|--------------------------|---|
| <u>Ottawa</u><br><small>(County)</small> | Located In:              | Corner Code #                                 |
| 1. Public Land Survey                    | T <u>8N</u> R <u>13W</u> | <u>H-11 (N 1/4, 34)</u><br><u>Wright Twp.</u> |
|  | T _____ R _____          | _____   |
|  | T _____ R _____          | _____   |
|  | T _____ R _____          | _____   |
| 2. Property Controlling<br>in Section    | S _____ T _____ R _____  | _____   |
|  | S _____ T _____ R _____  | _____   |
| 3. Miscellaneous<br>Property in Sec.     | S _____ T _____ R _____  | _____   |
|  | S _____ T _____ R _____  | _____   |

**RECORDED**

96 AUG 26 PM 2:02

*Debra K. Holtzman*  
REGISTER OF DEEDS  
OTTAWA COUNTY, MI

**Register of Deeds Stamp & File Number**

4. Lot No. \_\_\_\_\_, Recorded Plat \_\_\_\_\_  
5. Private Claims \_\_\_\_\_

| A  | B  | C  | D  | E  | F  | G  | H | I | J | K | L | M |
|----|----|----|----|----|----|----|---|---|---|---|---|---|
| 2  | 6  | 5  | 4  | 3  | 2  | 1  |   |   |   |   |   |   |
| 3  |    |    |    |    |    |    |   |   |   |   |   |   |
| 4  | 7  | 8  | 9  | 10 | 11 | 12 |   |   |   |   |   |   |
| 5  |    |    |    |    |    |    |   |   |   |   |   |   |
| 6  | 18 | 17 | 16 | 15 | 14 | 13 |   |   |   |   |   |   |
| 7  |    |    |    |    |    |    |   |   |   |   |   |   |
| 8  | 19 | 20 | 21 | 22 | 23 | 24 |   |   |   |   |   |   |
| 9  |    |    |    |    |    |    |   |   |   |   |   |   |
| 10 | 30 | 29 | 28 | 27 | 26 | 25 |   |   |   |   |   |   |
| 11 |    |    |    |    |    |    |   |   |   |   |   |   |
| 12 | 31 | 32 | 33 | 34 | 35 | 36 |   |   |   |   |   |   |
| 13 |    |    |    |    |    |    |   |   |   |   |   |   |

I, Donald W. Schiele, in a field survey on August 19, 1996, do hereby certify that under requirements of P.A. 74, Michigan P.A. of 1970, the corner points mentioned in lines 1 and 2 above were in conformance with regulations and rules therefore as required in the current manual of survey instructions of the United States Department of the Interior, Bureau of Land Management or by a decree of a Court of Law and/or that the corner points mentioned in lines 3, 4 and 5 above were in conformance with the rules of the Michigan Board of Land Surveyors or by a Decree of a Court of Law; established, re-established, monumented, re-monumented, recovered, found as expressed below:


**NOTE: Not more than 4 corners, all in the same town and range, may be recorded on this certificate.**

A. Description of original monument and accessories and/or subsequent restoration:

H-11 1/4 corner common to Sections 27 & 34, Wright Twp.  
Original Government Corner Record: L.C.R.C. recorded in Liber 4, Page 235, 10-22-81  
Set qr Sec post in Creek Set Cast Iron Monument  
Post 17" Oak North 23.95'  
Elm 20 N87E 51 Twin Bass NE 41.11'  
W. Oak 10 N80W 48 15" Oak East 32.83'  
Enoch Hammele, Deputy Surveyor 8" Ash South 13.67'  
Between 9-18 and 9-26, 1838

B. Description of corner evidence found and/or method applied in restoring or reestablishing corner:

H-11 Found Cast Iron Monument inscribed "Section Corner" 16" above surface of ground, and accepted as a careful and faithful perpetuation of the position of the original corner.  
Found nail in West side of 24" Oak N16°E 23.91'  
Found nail in NE side of 10" Twin Basswood N28°E 41.14'  
Found nail in NW side of 24" Oak N73°30'E 33.01'  
Found nail in South side of 14" Ash S68°E 49.39'  
Found nail in East side of 12" Ash S24°E 22.51'  
Centerline, dead 7" Ash S20°E 13.64'

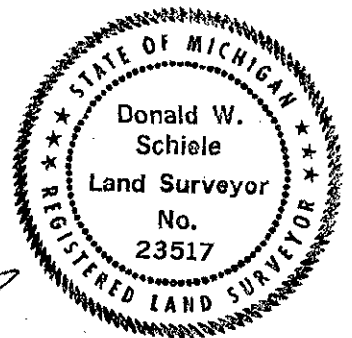

P.A. 345 OTTAWA COUNTY  
PEER APPROVED 8-20-96

*Donald W. Schiele*

C. Description of monument for corner and accessories established to perpetuate locating the position of the corner:

H-11 Replaced Cast Iron Monument inscribed "Section Corner" with 36"X3/4" Steel Bar with Ottawa County Remon Cap, 1" above ground level.  
Set Ottawa County Remon Tag & nail in East side of 24" Oak N16°E 24.12'  
Set Ottawa County Remon Tag & nail in South side of 24" Oak N73°30'E 33.43'  
Set Ottawa County Remon Tag & nail in SW side of 14" Ash S68°E 49.30'  
Set Ottawa County Remon Tag & nail in West side of 12" Ash S24°E 22.33'  
On approximate centerline of old fence line & occupation line to West.  
Centerline Creek, 13'± West.

Signed by Donald W. Schiele Date Aug 20, 1996  
Surveyor's Michigan License No. 23517