## RECORDED

97 JUL 24 PM 2: 26


OTTAWA	COUNTY	KEMONU	IMIEN LA	ULLU	V
LAND CORNE	R RECO	RDATIO	N CER	TIFIC	CATE
Filing Require	ement of	Act 74.	Mich.	P.A.	1970

For corners in	i mny nequit	entent of Act 74, Mich. P.A. 19.	Literal in the
Ottawa (Control	Located In:	Corner Code ##	REGISTER OF DEEDS OTTAWA COUNTY, MI
1. Public Land Survey	T <u>8N</u> R <u>13W</u>	I-1 (NW, 2) Wright Twp.	VITAIRA GUUNTY, MI
	TR TR STR		
3. Miscellaneous	S T R S T R S T R	F	Register of Deeds Stamp & File Number
4. Lot No, Rec	orded Plat		
5. Private Claims			— ABCDEFGHJKL
	e.	•	2 6 5 4 3 2 1
D. 144 C. 11	,	- 44	4 7 8 9 10 11 12
in lines 1 and 2 above were in co- current manual of survey instructi Management or by a decree of a Co- above were in conformance with the Court of Law; established, re-e	ements of P.A. 74, Michigan P.A., onformance with regulations and ons of the United States Depart ourt of Law and/or that the corne the rules of the Michigan Board o	e 11, 19 9/ of 1970, the corner points mentioned drules therefore as required in the ment of the Interior, Bureau of Land repoints mentioned in lines 3, 4 and 5 f Land Surveyors or by a Decree of a nonumented, recovered, found as	5 6 18 17 16 15 14 13 7 8 19 20 21 22 23 24
expressed below:	one all in the same town an	al managa (managa la companyal) al	10 30 29 28 27 26 25
NOTE: Not more than 4 corn on this certificate.	iers, all in the same town an	d range, may be recorded	12 31 32 33 34 35 36
I-1 Found Cast Iron Box, and accepte corner. Found nail in SW side Found hail in SW side Found Cast Iron Monum SW cor., Sec. 35, T Centerline, GTE Box Found nail in NE side	on 2, Wright Twp. orner Record: 2 and 3  Surveyor, for puty Surveyor , 1838  ence found and/or method a Monument inscribed " d as a careful and f  of 8" Apple of Power Pole ent in Monument Box, 9N, R13W  of Power Pole	L.C.R.C. recorded in L.  I-1 Found 3/4" Iron Pi C/L 16th Ave. (Running Nail in face of 10" App Nail in face of Power F Nail in face of 10" App Mich. Bell. Term.  (SEE REVI Applied in restoring or reestablishing Section Corner", 3" beloaithful perpetuation of  S40°E 60.30'(E) S22°30'E 101.54'(E)	ipe N.) W. 80' Ole SW. 72.50' Pole S. 95.15' Ole NE. 56.42' NW. 61.45'  ERSE)  Ing corner:  Ow asphalt surface in Monument the position of the original  OF M/(A)  Donald W. * Schiele * Land Surveyor No. 23517
I-1 Established amen of Sec. 35, T9N, Found Ottawa County R Found Ottawa County R Centerline, Cast Iron Cast Iron Monument in Set Ottawa County Rem Centerline dirt 2-tra Centerline asphalt ro	nded corner at inters R13W. Set Ottawa C Remon Tag & nail in M Remon Tag & nail in W n Monument n Monument Box, SW co non Tag & nail in NE nack South, 10'± East Dad East & West, 2.30	section of the West line County Remon Tag & PK na North side of 8" Apple West side of Power Pole or., Sec. 35, T9N, R13W side of Power Pole	of Sec. 2 with the S. line
(SEE SKETCH ON REVERS			OVED 7-21-97
	1 1 1 11	FEED AFFA	Un'M
Signed by	1 L. Schin	Date	une 16, 1997

Part A., continued:

L.C.R.C. recorded in L. 5, P. 328, 8-9-88:

Set CIM 56.10 52.85 101.55 NW10" Apple SSW PР SSE 8" Apple SE 60.32

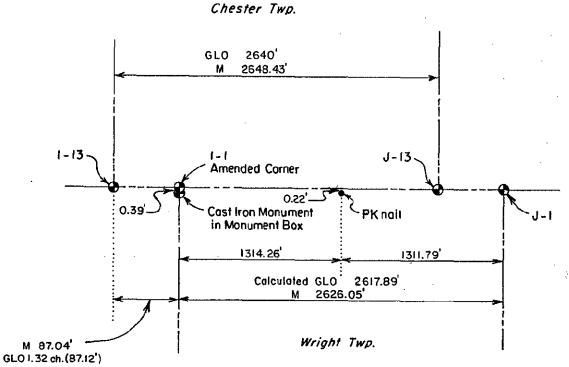

REMON LIBER 3 PAGE 521