

SURVEY & REMONUMENTATION

DEC 01 1993

COMMISSION

For corners in

**OTTAWA COUNTY REMONUMENTATION
LAND CORNER RECORDATION CERTIFICATE**
Filing Requirement of Act 74, Mich. P.A. 1970

RECORDED


93 NOV 11 AM 11:54

Phyllis Calloway
REGISTER OF DEEDS
OTTAWA COUNTY, MI

<u>Ottawa</u> (County)	Located In:	Corner Code #
1. Public Land Survey	T <u>8N</u> R <u>13W</u>	<u>I-9 (SE, 22)</u> <u>Wright Twp.</u>
	T _____ R _____	_____
	T _____ R _____	_____
2. Property Controlling In Section	S _____ T _____ R _____	_____
	S _____ T _____ R _____	_____
3. Miscellaneous Property in Sec.	S _____ T _____ R _____	_____
	S _____ T _____ R _____	_____
4. Lot No. _____, Recorded Plat _____		
5. Private Claims _____		

Register of Deeds Stamp & File Number

I, Donald W. Schiele, in a field survey on November 3, 19 93, do hereby certify that under requirements of P.A. 74, Michigan P.A. of 1970, the corner points mentioned in lines 1 and 2 above were in conformance with regulations and rules therefore as required in the current manual of survey instructions of the United States Department of the Interior, Bureau of Land Management or by a decree of a Court of Law and/or that the corner points mentioned in lines 3, 4 and 5 above were in conformance with the rules of the Michigan Board of Land Surveyors or by a Decree of a Court of Law; established, re-established, monumented, re-monumented, recovered, found as expressed below:

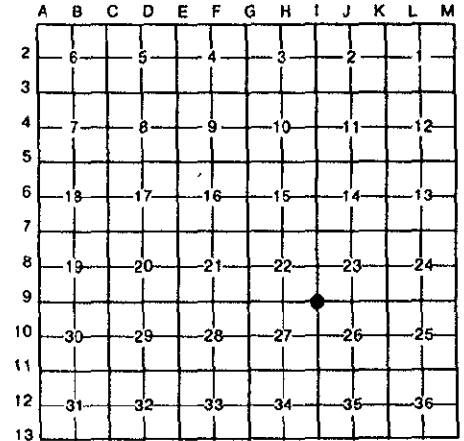


NOTE: Not more than 4 corners, all in the same town and range, may be recorded on this certificate.

A. Description of original monument and accessories and/or subsequent restoration:
I-9 corner common to Sections 22, 23, 26 and 27 Wright Twp.
L.C.R.C. recorded in Liber 1, Page 199, 12-23-71.
5/8" Iron in Mon Box
CP Pole S40°W 68.35'
CP Pole S30°E 60.60'
SE Cor Hse N40°E 109.28'

B. Description of corner evidence found and/or method applied in restoring or reestablishing corner:
I-9 Found 5/8" O.D. Pipe in Monument Box and accepted as a careful and faithful perpetuation of the position of the original corner.
PK nail in NW side of Power Pole SW 68.87'
Nail in SW side of Power Pole SE 60.92'
SE Corner House # 1591 NE 109.28'

C. Description of monument for corner and accessories established to perpetuate locating the position of the corner:
I-9 Set 3/4" X 24" solid bar with Ottawa County Remon Cap in Monument Box in place of 5/8" O.D. Pipe.
Set Ottawa County Remon Tag & nail in NW side of Guy Pole N28°E 66.26'
SE Corner House # 1591 N54°E 109.28'
Set Ottawa County Remon Tag & nail in SW side of Power Pole S34°E 61.07'
Set Ottawa County Remon Tag & nail in NW side of Power Pole S41°W 68.86'
Set Ottawa County Remon Tag & nail in NE side of 8" Triple Maple N52°W 93.91'
On Centerline asphalt roads North, South and West
Centerline asphalt road East, 2' South

Signed by Donald W. Schiele Date Nov. 8 1993
Surveyor's Michigan License No. 23517

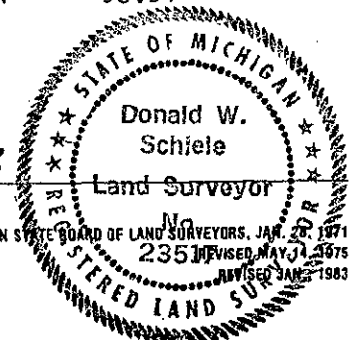

FORM APPROVED BY MICHIGAN STATE BOARD OF LAND SURVEYORS, JAN. 28, 1971
REVISED MAY 31, 1975
REVISED JAN 2, 1983