

**SURVEY &
REMONUMENTATION**

APR 05 1996

COMMISSION

**OTTAWA COUNTY REMONUMENTATION
LAND CORNER RECORDATION CERTIFICATE
Filing Requirement of Act 74, Mich. P.A. 1970**

For corners in
Ottawa

	Located in:	Corner Code #
(County)	Wright Twp.	
1. Public Land Survey	T 8N R 13W	J-5
	T R	N 1/4 Corner
	T R	Section 14
	T R	
2. Property Controlling in Section	S T R	
	S T R	
3. Miscellaneous Property in Sec.	S T R	
	S T R	

RECORDED

95 NOV 29 PM 1:48

Phyllis Kellerman
REGISTER OF DEEDS
OTTAWA COUNTY, MI

Register of Deeds Stamp & File Number

4. Lot No. _____, Recorded Plat _____
5. Private Claims _____

Carl P. Englert, Jr. in a field survey on October 31, 1995 do hereby state that under requirements of P.A. 74, Michigan P.A. of 1970, the corner points mentioned in lines 1 and 2 above were in conformance with regulations and rules therefore as required in the current manual of survey instructions of the United States Department of the Interior, Bureau of Land Management or by a decree of a Court of Law and/or that the corner points mentioned in lines 3, 4 and 5 above were in conformance with the rules of the Michigan Board of Land Surveyors or by a Decree of a Court of Law; established, re-established, monumented, recovered, found as expressed below:

1	A	B	C	D	E	F	G	H	I	J	K	L	M
2		6		5		4		3		2		1	
3													
4		7		8		9		10		11		12	
5										13			
6		18		17		16		15		14		13	
7													
8		19		20		21		22		23		24	
9													
10		30		29		28		27		26		25	
11													
12		31		32		33		34		35		36	
13													

NOTE: Not more than 2 corners, all in the same town and range, may be recorded on this certificate.

A. Description of original monument and accessories and/or subsequent restoration:

J-5 1/4 corner common to Section 11 & 14
Original corner set September, 1838 by Enock Hammele
Set 1/4 Section Post
Beech 12" N 51° W 29 Links
Sugar 14" S 18° E 9 Links

LCRC Liber 1, Page 195, 8/3/1971
"T" Iron
20" Maple N 40° E 38.65'
10" Oak S 20° W 24.40'
Fe Cor S. 26.40'
C.P. Pole S. 41.50'

see other side

B. Description of corner evidence found and/or method applied in restoring or reestablishing corner:

J-5 1/4 corner common to Sections 11 & 14
Found 4" Cast Iron Monument in Mon. Box
Found Fence Corner (down) 26'±
Found P.P. S. 42.05'

PA. 345 OTTAWA COUNTY
PEER APPROVED 11-20-95

Robert P. Hedewald
RPN


Accepted as a careful and faithful perpetuation of the position of the original corner

C. Description of monument for corner and accessories established to perpetuate locating the position of the corner:

J-5 1/4 corner common to Sections 11 & 14
4" Cast Iron Monument in Mon. Box in Road Centerline
Ottawa County Remonumentation tag and nail in W. side 24" Oak S 02° E 53.66'
Ottawa County Remonumentation tag and nail in E. side P.P. South 42.03'
Ottawa County Remonumentation tag and nail in N. side P.P. S 83° E 319.37'
Ottawa County Remonumentation tag and nail in S. side 12" Elm N 84° E 299.84'
Fence Line South
Ottawa County Remonumentation tag and nail in S side P.P. S 78° W 210.06'

Signed by Carl P. Englert Jr.
Surveyor's Michigan License No. 18987

Date 11/10/1995

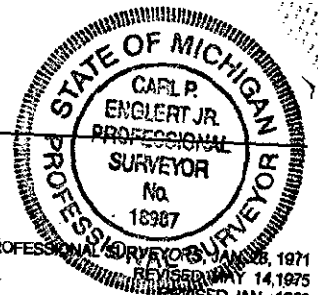

J-5 T8N, R13W
LCRC Liber 3, Page 62
Fd Stone & "T" Iron, Set Cast Iron Mon.
P.P. S. 42.05'
12" Oak SSE 53.7'

\$ 11.00 CORNER
\$ 185.00 PHOTO