

RECORDED

OTTAWA COUNTY REMONUMENTATION
LAND CORNER RECORDATION CERTIFICATE 96 DEC 18 PM 4: 55
 Filing Requirement of Act 74, Mich. P.A. 1970

For corners in

<u>Ottawa</u> <small>(County)</small>	Located in:	Corner Code #	
1. Public Land Survey	T <u>8N</u> R <u>13W</u>	<u>J-13 (S$\frac{1}{4}$, 35)</u>	<u>Wright Twp.</u>
	T _____ R _____	_____	_____
	T _____ R _____	_____	_____
2. Property Controlling in Section	S _____ T _____ R _____	_____	_____
	S _____ T _____ R _____	_____	_____
3. Miscellaneous Property in Sec.	S _____ T _____ R _____	_____	_____
	S _____ T _____ R _____	_____	_____
4. Lot No. _____, Recorded Plat _____			
5. Private Claims _____			

Richard R. Hollman
 REGISTER OF DEEDS
 OTTAWA COUNTY, MI

Register of Deeds Stamp & File Number

I, Donald W. Schiele, in a field survey on November 19, 19 96, do hereby certify that under requirements of P.A. 74, Michigan P.A. of 1970, the corner points mentioned in lines 1 and 2 above were in conformance with regulations and rules therefore as required in the current manual of survey instructions of the United States Department of the Interior, Bureau of Land Management or by a decree of a Court of Law and/or that the corner points mentioned in lines 3, 4 and 5 above were in conformance with the rules of the Michigan Board of Land Surveyors or by a Decree of a Court of Law; established, re-established, monumented, re-monumented, recovered, found as expressed below:

	A	B	C	D	E	F	G	H	I	J	K	L	M
2	6	5	4	3	2	1							
3													
4	7	8	9	10	11	12							
5													
6	18	17	16	15	14	13							
7													
8	19	20	21	22	23	24							
9													
10	30	29	28	27	26	25							
11													
12	31	32	33	34	35	36							
13													

NOTE: Not more than 4 corners, all in the same town and range, may be recorded on this certificate.

A. Description of original monument and accessories and/or subsequent restoration:

J-13 South $\frac{1}{4}$ corner of Section 35, Wright Township
 Original Government Corner Record:
 Set qr sec post on South side Sec. 35
 Post
 Beech 9 N40E 6
 Sugar 7 N83W 14
 Noah Brookfield, Deputy Surveyor
 April 12, 1837


PA. 205 OTTAWA COUNTY

PEER APPROVED 12-9-96
M.D.N.
 (SEE REVERSE)

B. Description of corner evidence found and/or method applied in restoring or reestablishing corner:

J-13 Found $\frac{1}{4}$ " dia. Brass Plug, 5" below asphalt surfaced concrete road in Monument Box, and accepted as a careful and faithful perpetuation of the position of the original corner.

SW corner, brick garage	N24°30'E	193.19' (E)
Found nail in NW side of Power Pole	N42°E	79.13' (E)
Found Brass Plug in Monument Box	N89°30'E	37.38' (E)
Found MSHD Tag & nail in SW side of Power Pole	S35°E	59.51' (E)
Found PK nail in South side of Telephone Pole	S58°30'W	42.61' (E)
Found nail in SW side of 30" Maple	N62°W	74.57' (E)
SE corner, house foundation	N36°30'W	120.54' (E)
C/L 25" Chestnut	N34°W	78.6' (E)

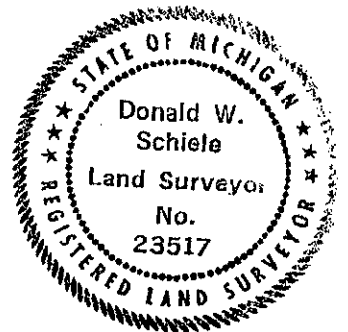

C. Description of monument for corner and accessories established to perpetuate locating the position of the corner:

J-13 $\frac{1}{4}$ " dia. Brass Plug, 5" below asphalt surfaced concrete road in Monument Box.

SW corner, brick garage	N24°30'E	193.19' (E)
Set Ottawa County Remon Tag & nail in SE side of Power Pole	N42°E	79.29' (E)
Brass Plug in Monument Box	N89°30'E	37.38' (E)
Set Ottawa County Remon Tag & nail in NE side of Telephone Pole	S73°E	71.54' (E)
Set Ottawa County Remon Tag & nail in SW side of Power Pole	S35°E	59.50' (E)
Set Ottawa County Remon Tag & nail in NW side of Telephone Pole	S58°30'W	42.52' (E)
Set Ottawa County Remon Tag & nail in SW side of 30" Maple	N62°W	74.56' (E)
SE corner, house foundation	N36°30'W	120.54' (E)

On centerline asphalt road East & West Centerline occupation line North, 3'± East
 Centerline asphalt road South, 6' East (SEE SKETCH ON REVERSE)

Signed by Donald W. Schiele Date December 8, 1996

Surveyor's Michigan License No. 23517

Part A., continued:

L.C.R.C. recorded in L. 6, P. 86, 1-28-91:

J-1, T7N, R13W

Found 1" Solid Iron in Mon. Box in
Conc. Rd.

Tel. Pole SW 42.63
PP SE 59.52
PP NE 79.21
36" Maple NW 74.70
Wright Twp. Cor. E 37.37

Note: The above description and witnesses
match the physical location of the
object described in the following
records:

T & H Associates witness book (no date)
for S ¼ cor., Sec. 35, T8N, R13W:

Fd 1/2" Brass Plug (Rd Comm)
C/L Crack S 0.10'
SE Cor. Hse NW 120.40'
P.P. NE 78.75'
SW Cor Hse NE 193.23'

T & H Associates witness book (no date)
for N ¼ cor., Sec. 2, T7N, R13W:

Brass Plug in Pavmt.
S75°W to T.P. 78.80'
N55°W to 12" Chestnut 78.30'
N65°W to 12" Maple 73.80'

Ottawa County Road Commission witnesses
(last confirmed 8-27-78):

1½" Brass Plug, N ¼ cor., Sec. 2, T7N, R13W
Boat Spike in P.P. NE 79.05'
Nail & tag in P.P. SE 59.52'
T.P. S75°W 78.8'
12" Maple N65°W 73.8'
12" Chestnut N35°W 78.87'

ACCEPTED AS J-13

L.C.R.C. recorded in L. 6, P. 88, 1-28-91:

J-13, T8N, R13W

Found Iron in Mon. Box in Conc. Road

PP NNE 60.82
Tel. Pole SE 37.65
PP SSW 49.04
Tallmadge Cor. W 37.37

Note: The above description and witnesses
match the physical location of the
object described in the following
record:

Tallmadge Township witness sheet
(Rev. Jan. 1966):

Stone & Brass Plug, N ¼ cor., Sec. 2
C.P. Pole NNE 60.15
18" Maple WNW 107.85
10" Elm ENE 118.0'
M.B.T. Pole SE 37.05
Brass Plug W 37.35

REJECTED AS J-13

