

**OTTAWA COUNTY REMONUMENTATION  
LAND CORNER RECORDATION CERTIFICATE  
Filing Requirement of Act 74, Mich. P.A. 1970**

RECORDED

97 JUL 24 PM 2:26

*Phyllis Redman*  
REGISTER OF DEEDS  
OTTAWA COUNTY, MI

For corners in

<u>Ottawa</u> (County)	Located In:	Corner Code #
1. Public Land Survey	T 8N R 13W	K-1 (NE, 2)
	T _____ R _____	Wright Twp.
	T _____ R _____	_____
	T _____ R _____	_____
2. Property Controlling in Section	S _____ T _____ R _____	_____
	S _____ T _____ R _____	_____
3. Miscellaneous Property in Sec.	S _____ T _____ R _____	_____
	S _____ T _____ R _____	_____

Register of Deeds Stamp & File Number

4. Lot No. \_\_\_\_\_, Recorded Plat \_\_\_\_\_  
5. Private Claims \_\_\_\_\_

	A	B	C	D	E	F	G	H	I	J	K	L	M
2	6	5	4	3	2	1							
3													
4	7	8	9	10	11	12							
5													
6	18	17	16	15	14	13							
7													
8	19	20	21	22	23	24							
9													
10	30	29	28	27	26	25							
11													
12	31	32	33	34	35	36							
13													

I, Donald W. Schiele, in a field survey on June 11, 19 97, do hereby certify that under requirements of P.A. 74, Michigan P.A. of 1970, the corner points mentioned in lines 1 and 2 above were in conformance with regulations and rules therefore as required in the current manual of survey instructions of the United States Department of the Interior, Bureau of Land Management or by a decree of a Court of Law and/or that the corner points mentioned in lines 3, 4 and 5 above were in conformance with the rules of the Michigan Board of Land Surveyors or by a Decree of a Court of Law; established, re-established, monumented, re-monumented, recovered, found as expressed below:


**NOTE: Not more than 4 corners, all in the same town and range, may be recorded on this certificate.**

**A. Description of original monument and accessories and/or subsequent restoration:**

K-1 NE corner, Section 2, Wright Twp.  
Original Government Corner Record: From Ottawa County Surveyor records:  
Set post cor to Secs 1 and 2 (no date): Planted Gas Pipe  
Post 10" Elm SE 44.5'  
Beech 16 S63W 5 Power Pole SE 32.0'  
Sugar 10 S60E 20 Fence cor. NW 35.0' (SEE REVERSE)  
Enoch Hammele, Deputy Surveyor, for Large Stone W 43'  
Russelas Whitcomb, Deputy Surveyor 30" Apple SW 61.5'  
Between 9-18 and 9-26, 1838

**B. Description of corner evidence found and/or method applied in restoring or reestablishing corner:**

K-1 Found Cast Iron Monument inscribed "Section Corner", 4 1/2" below asphalt surface in Monument Box, and accepted as a careful and faithful perpetuation of the position of the original corner.  
Found nail & tag #18435 in NW side of Power Pole N32°30'E 37.97' (E)  
Found nail & tag #18435 in West side of Power Pole S09°30'E 142.13' (E)  
Found PK nail in West side of Power Pole S09°30'E 141.86' (E)  
Found Cast Iron Monument in Monument Box, SE cor., Sec. 35, T9N, R13W S89°30'W 42.90'  
Found Angle Iron N64°30'E 3.49'  
Rejected as K-1. No surveys or irons found agree with angle iron as correct corner location.  
Found broken signpost base S52°30'W 47.2'±

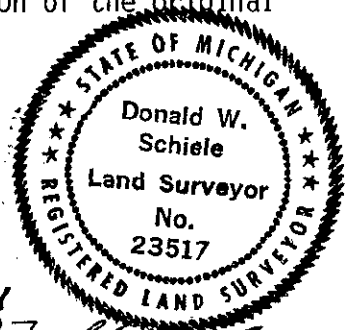

**P.A. 345 OTTAWA COUNTY  
PEER APPROVED 7-21-97**

**C. Description of monument for corner and accessories established to perpetuate locating the position of the corner:**

K-1 Established amended corner at intersection of the East line of Sec. 2 with the S. line of Sec. 36, T9N, R13W, which point falls on the inner rim of the existing Monument Box.  
Found Ottawa County Remon Tag & nail in NW side of Power Pole N32°30'E 38.15' (E)  
Found Ottawa County Remon Tag & nail in West side of Power Pole S09°30'E 141.76' (E)  
Cast Iron Monument in Monument Box, SE cor., Sec. 35, T9N, R13W S90°W 42.90'  
Found chiselled "X" in West end of 15" concrete culvert N23°W 177.85' (E)  
Centerline, Cast Iron Monument N02°W 0.21'  
Centerline asphalt road South, 4.6' West  
Centerline asphalt road East & West, 0.6' South  
Angle Iron N61°30'E 3.58'

(SEE SKETCH ON REVERSE)

Signed by Donald W. Schiele Date July 21, 1997  
Surveyor's Michigan License No. 23517

Part A., continued:

From Ottawa County Surveyor records, 1961:

Found T Iron  
 S50W 54.0 to St. Sign  
 N80W 88.0 to T.P.  
 S45E 48.3 to T.P.

From Terrill, Kistler & Anderson survey,  
 3-2-61:

Found "T" Iron. Raised with Angle Iron  
 N15°W 28.2 to P.P.  
 S45°E 48.35 to P.P.  
 S50°W 50.4 to St. Sign  
 N80°W 87.9 to T.P.

From Williams & Works survey for  
 Consumers Power Co., 1968:

NE cor. Sec. 2 (T8N, R13W)  
 Set Iron  
 Power Pole North 28.88'  
 Power Pole SSE 143.95'  
 Street Sign SW 46.80'

From J. Kistler & Associates survey,  
 4-17-78: L.3, P.807 & 808, O.C.R.

NW cor., Sec. 1, T8N, R13W  
 Found 1" Iron  
 P.P. N 28.88'  
 P.P. SSE 143.95'  
 St. Sign SW 46.80'

From field notes, Nederveld & Associates,  
 9-27-80:

Found "T" Iron @ NW cor. Sec.1  
 "T" Iron W. 42.94 GLO=42.9'  
 Set PK on W. side P.Pole NE 38.0  
 C/L St. Sign SW 47.1  
 Set PK on W. side P.Pole SSE 141.88

