

SURVEY & REMONUMENTATION

OCT 07 1996

COMMISSION

OTTAWA COUNTY REMONUMENTATION LAND CORNER RECORDATION CERTIFICATE Filing Requirement of Act 74, Mich. P.A. 1970

RECORDED

96 AUG 26 PM 2:03

Richard Holbrook
REGISTER OF DEEDS
OTTAWA COUNTY, MI

For corners in Wright Twp.
Ottawa Located In: Corner Code #
(County)

1. Public Land Survey	T <u>8N</u> R <u>13W</u>	<u>K-2</u>
	T <u> </u> R <u> </u>	<u>W 1/4 corner</u>
	T <u> </u> R <u> </u>	<u>Section 1</u>
	T <u> </u> R <u> </u>	<u> </u>
2. Property Controlling in Section	S <u> </u> T <u> </u> R <u> </u>	<u> </u>
	S <u> </u> T <u> </u> R <u> </u>	<u> </u>
3. Miscellaneous Property in Sec.	S <u> </u> T <u> </u> R <u> </u>	<u> </u>
	S <u> </u> T <u> </u> R <u> </u>	<u> </u>

4. Lot No. , Recorded Plat
5. Private Claims

Register of Deeds Stamp & File Number

I, Carl P. Englert, Jr., in a field survey on November 17, 1995 do hereby state that under requirements of P.A. 74, Michigan P.A. of 1970, the corner points mentioned in lines 1 and 2 above were in conformance with regulations and rules therefore as required in the current manual of survey instructions of the United States Department of the Interior, Bureau of Land Management or by a decree of a Court of Law and/or that the corner points mentioned in lines 3, 4 and 5 above were in conformance with the rules of the Michigan Board of Land Surveyors or by a Decree of a Court of Law; established, re-established, monumented, recovered, found as expressed below:

NOTE: Not more than 2 corners, all in the same town and range, may be recorded on this certificate.

A	B	C	D	E	F	G	H	I	J	K	L	M
1												
2	6	5	4	3	2	1						
3												
4	7	8	9	10	11	12						
5												
6	18	17	16	15	14	13						
7												
8	19	20	21	22	23	24						
9												
10	30	29	28	27	26	25						
11												
12	31	32	33	34	35	36						
13												

A. Description of original monument and accessories and/or subsequent restoration:

K-2 1/4 corner common to Sections 1 & 2
Original Gov't corner Set September 1838
by Enoch Hammele
Set 1/4 Section Post
Lynn 30" S 64° E 18 Links
Beech 13" N 8° W 22 Links

LCRC Liber 2, Page 283 7/17/1973
Angle Iron in Mon. Box
Power Pole NE 49.11'
30" Maple NE 47.67'
NW Cor. Church SE 90.11'
NE Cor. House SW 86.38'
Street Sign SE 18.30'

See Other Side

B. Description of corner evidence found and/or method applied in restoring or reestablishing corner:

K-2 1/4 Corner common to Sections 1 & 2
Found 3" Cast Iron Monument in Mon. Box
Found P.P. NE 49.68'
Found NW Corner Church SE 90.11'
Found NE Corner House SW 86.38'±
Found P.P. SE 57.30'

P.A. 345 OTTAWA COUNTY
PEER APPROVED 12/11/95

Richard D. Hedwood


Accepted as a careful and faithful perpetuation of the position of the original corner.

C. Description of monument for corner and accessories established to perpetuate locating the position of the corner:

K-2 1/4 Corner common to Sections 1 & 2
3" Cast Iron Monument in Mon Box
Ottawa County Remonumentation tag and nail in W. Side P.P. N 29° E 49.70'
Ottawa County Remonumentation tag and nail in E. Side P.P. S 25° E 57.18'
Ottawa County Remonumentation tag and nail in S. Side 14" Maple S 60° W 72.46'
SW Corner of Brick House S 77° E 55.15'
Corner is 5'± East of CL Asphalt Road.

Signed by Carl P. Englert
Surveyor's Michigan License No. 18987

Date 12/9/1995

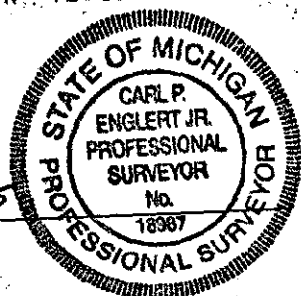

K-2 T 8 N, R 13 W
LCRC Liber 6, Page 97 10/30/90
Found angle iron in Mon Box, Set CIM
12" Maple SW 72.24'
T.P. NE 49.68'
NE cor Bar NW 102.46'
P.P. SE 57.30'

**SURVEY &
REMONUMENTATION**

OCT 07 1996

COMMISSION

\$ 11.00 CORNER
\$ 1.00 PHOTO
\$ 1.00 PHOTO