

APR 05 1996

OTTAWA COUNTY REMONUMENTATION
COMMISSION LAND CORNER RECORDATION CERTIFICATE
Filing Requirement of Act 74, Mich. P.A. 1970

RECORDED

95 DEC 12 AM 11:51

Phyllis Robinson
REGISTER OF DEEDS
OTTAWA COUNTY, MI

For corners in

<u>OTTAWA</u> (County)	Located In: Wright Twp.	Corner Code # K-3
1. Public Land Survey	T <u>8N</u> R <u>13W</u>	<u>SW corner</u>
	T ___ R ___	<u>Section 1</u>
	T ___ R ___	_____
	T ___ R ___	_____
2. Property Controlling in Section	S ___ T ___ R ___	_____
	S ___ T ___ R ___	_____
3. Miscellaneous Property in Sec.	S ___ T ___ R ___	_____
	S ___ T ___ R ___	_____

Register of Deeds Stamp & File Number

4. Lot No. _____, Recorded Plat _____
5. Private Claims _____

I, Carl P. Englert, Jr., in a field survey on November 17, 1995 do hereby state that under requirements of P.A. 74, Michigan P.A. of 1970, the corner points mentioned in lines 1 and 2 above were in conformance with regulations and rules therefore as required in the current manual of survey instructions of the United States Department of the Interior, Bureau of Land Management or by a decree of a Court of Law and /or that the corner points mentioned in lines 3, 4 and 5 above were in conformance with the rules of the Michigan Board of Land Surveyors or by a Decree of a Court of Law; established, re-established, monumented, recovered, found as expressed below:

NOTE: Not more than 2 corners, all in the same town and range, may be recorded on this certificate.

A	B	C	D	E	F	G	H	I	J	K	L	M
1												
2	6	5	4	3	2	1						
3										⊕		
4	7	8	9	10	11	12						
5												
6	18	17	16	15	14	13						
7												
8	19	20	21	22	23	24						
9												
10	30	29	28	27	26	25						
11												
12	31	32	33	34	35	36						
13												

A. Description of original monument and accessories and/or subsequent restoration:

K-3 Corner common to sections 1,2,11 & 12
Original Gov't corner set September 1838 by Enoch Hammele
Set post
Sugar 16" N 45° E 8 links
Beech 8" S 69° W 22 links
LCRC Liber 2, Page 283, 7/17/1973
Set 60D spike from ties
Power Pole N 45° E 63.28'
Power Pole N 85° W 39.07'
Centerline asphalt W 0.5'
Centerline street sign 27.08'

SEE OTHER SIDE

B. Description of corner evidence found and/or method applied in restoring or reestablishing corner:

K-3 Corner common to sections 1,2,11 & 12
Found cast iron monument with top broken off in monument box
Found P.P. NE 63.85'
Found 8" Maple NW 53.83'
Found P.P. WNW 39.08'
P.A. 345 OTTAWA COUNTY
PEER APPROVED 11/20/1995

Richard P. Nedwell 11/20/1995


Accepted as a careful and faithful perpetuation of the position of the original corner.

C. Description of monument for corner and accessories established to perpetuate locating the position of the corner:

K-3 Corner common to sections 1,2,11 & 12
4" cast iron monument with top broken off in monument box
Ottawa County Remonumentation tag and nail in S side P.P. N 81° E 302.20'
Ottawa County Remonumentation tag and nail in SE side P.P. N 28° E 63.64'
Ottawa County Remonumentation tag and nail in NE side 12" Birch N 27° W 116.78'
Ottawa County Remonumentation tag and nail in N side 12" Maple N 56° W 53.90'
Centerline pavement West 0.5'

Signed by Carl P. Englert Jr.
Surveyor's Michigan License No. 18987

Date 11/20/1995

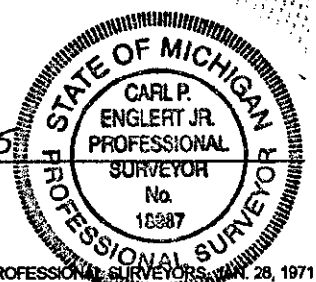

K-3 Town 8 North, Range 13 West
LCRC Liber 6, Page 99, 10/30/1990
Found rod spike in pavement, Set CIM
P.P. NE 63.85'
Street sign W 27.02'
8" Maple NW 53.83'
P.P. WNW 39.08'

\$ 11.00 CORNER