

# SURVEY & REMONUMENTATION

APR 24 1995

COMMISSION

OTTAWA COUNTY REMONUMENTATION  
LAND CORNER RECORDATION CERTIFICATE  
Filing Requirement of Act 74, Mich. P.A. 1970

RECORDED

94 DEC 15 AM 11:46

For corners in

<u>Ottawa</u> <small>(County)</small>	Located In:	Corner Code #
1. Public Land Survey	T <u>8N</u> R <u>13W</u>	<u>K-11 (NW, 36)</u> <u>Wright Twp.</u>
	T _____ R _____	_____
	T _____ R _____	_____
	T _____ R _____	_____
2. Property Controlling in Section	S _____ T _____ R _____	_____
	S _____ T _____ R _____	_____
3. Miscellaneous Property in Sec.	S _____ T _____ R _____	_____
	S _____ T _____ R _____	_____

*Phyllis Kallman*  
REGISTER OF DEEDS  
OTTAWA COUNTY, MI

Register of Deeds Stamp & File Number

4. Lot No. \_\_\_\_\_, Recorded Plat \_\_\_\_\_  
5. Private Claims \_\_\_\_\_

I, Donald W. Schiele, in a field survey on November 30, 1994, do hereby certify that under requirements of P.A. 74, Michigan P.A. of 1970, the corner points mentioned in lines 1 and 2 above were in conformance with regulations and rules therefore as required in the current manual of survey instructions of the United States Department of the Interior, Bureau of Land Management or by a decree of a Court of Law and/or that the corner points mentioned in lines 3, 4 and 5 above were in conformance with the rules of the Michigan Board of Land Surveyors or by a Decree of a Court of Law; established, re-established, monumented, re-monumented, recovered, found as expressed below:

	A	B	C	D	E	F	G	H	I	J	K	L	M
2	6	5	4	3	2	1							
3													
4	7	8	9	10	11	12							
5													
6	18	17	16	15	14	13							
7													
8	19	20	21	22	23	24							
9													
10	30	29	28	27	26	25							
11													
12	31	32	33	34	35	36							
13													

**NOTE: Not more than 4 corners, all in the same town and range, may be recorded on this certificate.**

A. Description of original monument and accessories and/or subsequent restoration:  
K-11 corner common to Sections 25, 26, 35 & 36, Wright Twp.


Original Government Corner Record:	L.C.R.C. recorded in Liber 2, Page 761, 4-3-75
Set corner post Sec. 25, 26, 35, 36.	1/2" Rebar in mon box
Post	St. sign S40°W 32.7'
Swamp Ash 10 N67E 5	CP pole N30°W 49.38'
Cedar 12 N60W 13	CP pole N30°E 47.55'
Enoch Hammele, Deputy Surveyor	C/L x rds
Between 9-18 and 9-26, 1838	

B. Description of corner evidence found and/or method applied in restoring or reestablishing corner:

K-11 Found 5/8" X 24" Pointed Rebar, 5" below surface in Monument Box, and accepted as a careful and faithful perpetuation of the position of the original corner.

Found PK nail in NW side of Guy Pole	N24°30'E	66.67'
Found PK nail in NW side of Guy Pole	N24°30'E	66.63'
Found PK nail in East side of Power Pole	N24°30'W	49.34'
Found PK nail in NE side of Power Pole	N24°30'W	49.72'
Found nail in SE side of Power Pole	N24°30'W	49.09'
Centerline asphalt road North & South, 0.2' East		
Centerline asphalt road West, 0.5' North		
On centerline gravel road to East		

P.A. 345 OTTAWA COUNTY  
PEER APPROVED

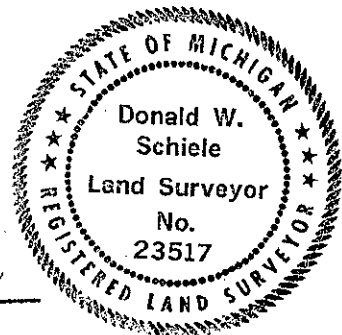

C. Description of monument for corner and accessories established to perpetuate locating the position of the corner:  
K-11 Removed 5/8" X 24" Pointed Rebar, and replaced with 3/4" X 24" Steel Bar with Ottawa County Remon Cap, 2 1/2" below surface in Monument Box.

Set Ottawa County Remon Tag & nail in NW side of Guy Pole	N24°30'E	66.53'
Set Ottawa County Remon Tag & nail in East side of Power Pole	S14°W	184.87' (E)
Set Ottawa County Remon Tag & nail in NW side of 5" Elm	S74°30'W	141.06' (E)
Set Ottawa County Remon Tag & nail in North side of Power Pole	S82°W	207.14' (E)
Set Ottawa County Remon Tag & nail in NE side of Power Pole	N24°30'W	49.64'
Centerline asphalt road North & South, 0.2' East		
Centerline asphalt road West, 0.5' North		
On centerline gravel road to East		

Signed by Donald W. Schiele

Date Dec. 12, 1994

Surveyor's Michigan License No. 23517

FORM APPROVED BY MICHIGAN STATE BOARD OF LAND SURVEYORS, JAN. 28, 1971  
REVISED MAY 14, 1975  
REVISED JAN., 1983