

SURVEY & REMONUMENTATION

JUN 28 1999

RECORDED

OTTAWA COUNTY REMONUMENTATION

98 NOV -4 PM 2:32

SECTION

LAND CORNER RECORDATION CERTIFICATE
Filing Requirement of Act 74, Mich. P.A. 1970

Sam Schell
REGISTER OF DEEDS
OTTAWA COUNTY, MI

For corners in

OTTAWA
(County)

Located in:

Corner Code #

- | | | | | | | |
|------------------------------------|---|---|---|----|---|---------------------|
| 1. Public Land Survey | T | 8 | R | 13 | W | L-1 N 1/4 Cor Sec 1 |
| | T | | R | | | Wright Twp |
| | T | | R | | | |
| | T | | R | | | |
| 2. Property Controlling in Section | S | | T | | R | |
| | S | | T | | R | |
| 3. Miscellaneous Property in Sec. | S | | T | | R | |
| | S | | T | | R | |

Register of Deeds Stamp & File Number

4. Lot No. _____, Recorded Plat _____
5. Private Claims _____

I, Randal J. Vugteveen, in a field survey on September 29, 1998 do hereby state that under requirements of P.A. 74, Michigan P.A. of 1970, the corner points mentioned in lines 1 and 2 above were in conformance with regulations and rules therefore as required in the current manual of survey instructions of the United States Department of the Interior, Bureau of Land Management or by a decree of a Court of Law and/or that the corner points mentioned in lines 3, 4 and 5 above were in conformance with the rules of the Michigan Board of Land Surveyors or by a Decree of a Court of Law, established, re-established, monumented, recovered, found as expressed below:

NOTE: Not more than 2 corners, all in the same town and range, may be recorded on this certificate.

	A	B	C	D	E	F	G	H	I	J	K	L	M
1													
2	6		5		4		3		2		1		
3													
4	7		8		9		10		11		12		
5													
6	10		17		16		15		14		13		
7													
8	19		20		21		22		23		24		
9													
10	30		29		28		27		26		25		
11													
12	31		32		33		34		35		36		
13													

A. Description of original monument and accessories and/or subsequent restoration:

L-1 Corner was not set by GLO

L-1 Liber 5 Page 328
Joiner 1988
Set C.I.M.
Chester Twp Cor W 21.60'
16" Apple Tree SSW 93.34'
12" Apple Tree SW 108.37'
24" Apple Tree N 26.53'

B. Description of corner evidence found and/or method applied in restoring or reestablishing corner:

Found Cast Iron Monument in Mon Box
Cast Iron Mon West 21.57' (Chester Twp Cor)

This position not established by original government surveyors. Accepted Cast Iron Monument as the best available evidence of the position of the corner.

C. Description of monument for corner and accessories established to perpetuate locating the position of the corner:

Found Cast Iron Monument in Mon Box 0.16' South of Town line Witnesses to Monument

Centerline of Blacktop South 7.5'
Found Remon Tag and Nail S side 16" Apple N56°E 47.09'
Set Remon Tag and Nail NW Cor RR tie on Apple Row S15°W 63.86'
Set Remon Tag and Nail N side 3" Apple S43°E 73.99'
Set Remon Tag and Nail SW side 12" Apple N52°W 105.16'
Cast Iron Monument at Chester Corner 21.57' West

10/19/98
YDY



\$11.00 CORNER
Receipt #18213
\$2.00 PHOTO
Receipt #18213

Signed by Randal J. Vugteveen
Surveyor's Michigan License No. 28429

Date OCTOBER 19, 1998


SURVEY &
REMONUMENTATION

JUN 28 1999

SECTION

CHESTER TWP

WRIGHT TWP

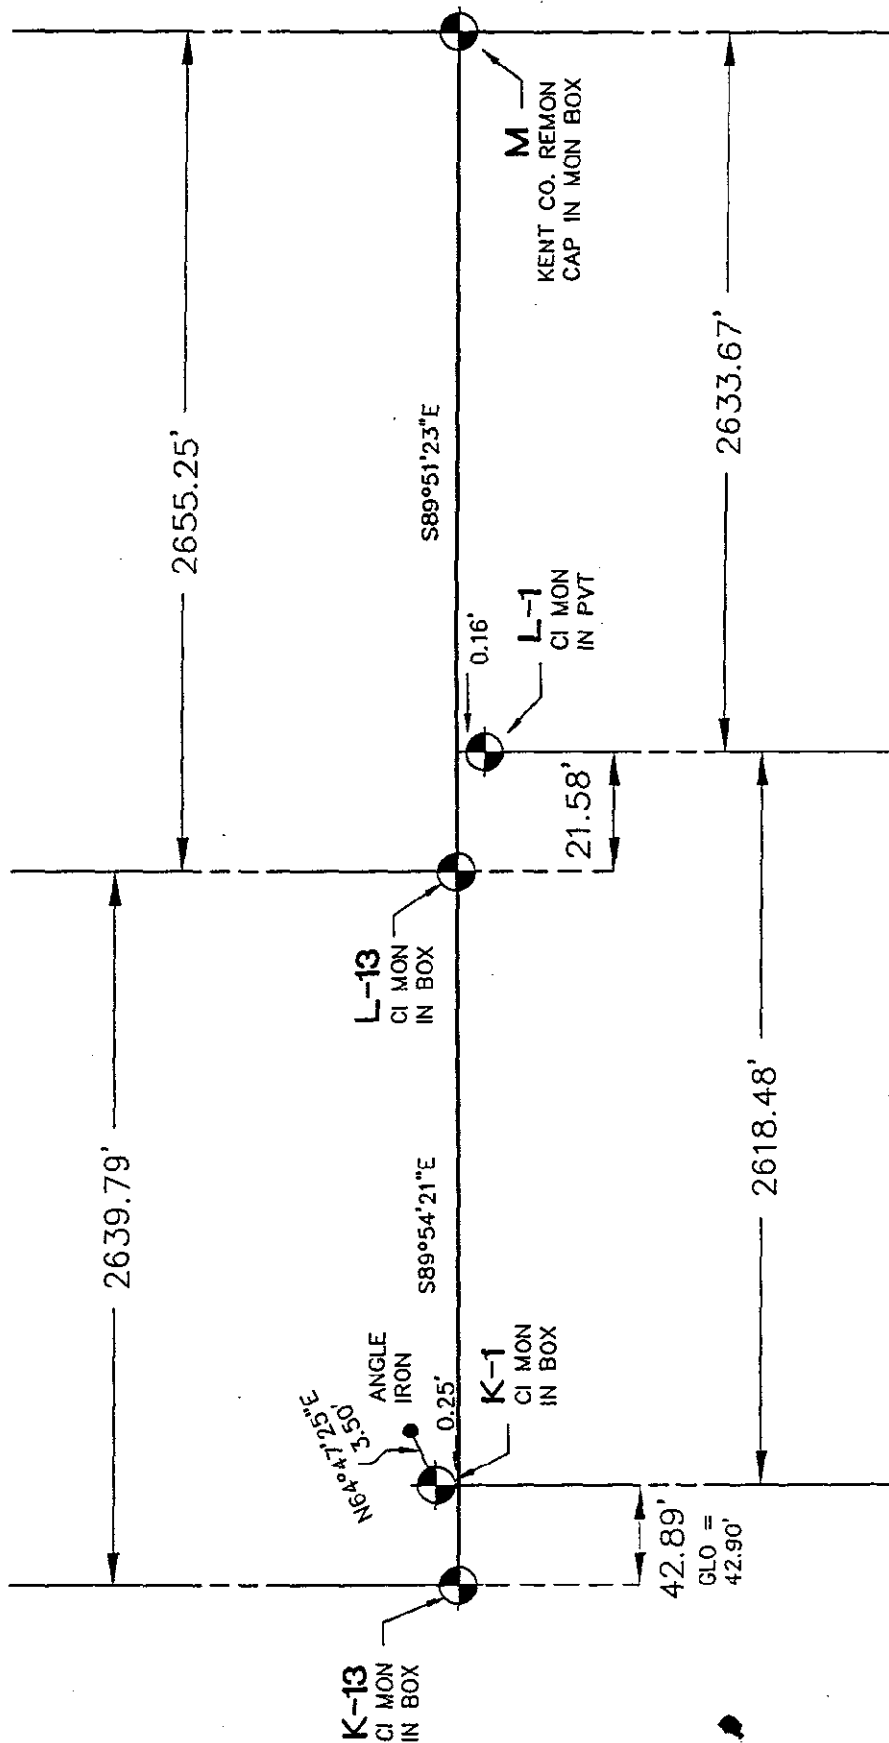

Scale 1" =

- D = Description dimension
- M = Measured dimension
- P = Platted dimension
- = Set iron stake
- O = Found iron stake
- x — Fence Line

By *Randal J. Vugteveen*
Randal J. Vugteveen Licensed Professional Surveyor No. 28429

nederveld associates, inc
engineering • surveying

Grand Rapids Location, Ph. (616) 669-5190 Fax 669-6668
P.O. Box 10, 5570 32nd Avenue, Hudsonville, Michigan 49426
Holland Location, Ph. (616) 393-0449 Fax 392-3540
575 E. 16th Street, Holland, Michigan 49423
Norton Shores Location, Ph. (616) 733-4114 Fax 733-5303
374 Somnole Road, Norton Shores, Michigan 49444
File No. 980002 Date: 10-9-98 by G

NO SCALE