

# SURVEY & REMONUMENTATION

APR 24 1995

## OTTAWA COUNTY REMONUMENTATION LAND CORNER RECORDATION CERTIFICATE Filing Requirement of Act 74, Mich. P.A. 1970

RECORDED

94 DEC 15 AM 11:47

For corners in **COMMISSION**

*Deputy Register*  
REGISTER OF DEEDS  
OTTAWA COUNTY, MI

Ottawa (County)	Located In:	Corner Code -#
1. Public Land Survey	T <u>8N</u> R <u>13W</u>	L-13 (S $\frac{1}{4}$ , 36) Wright Twp.
	T _____ R _____	_____
	T _____ R _____	_____
	T _____ R _____	_____
2. Property Controlling in Section	S _____ T _____ R _____	_____
	S _____ T _____ R _____	_____
3. Miscellaneous Property in Sec.	S _____ T _____ R _____	_____
	S _____ T _____ R _____	_____

Register of Deeds Stamp & File Number

4. Lot No. \_\_\_\_\_, Recorded Plat \_\_\_\_\_  
5. Private Claims \_\_\_\_\_

I, Donald W. Schiele, in a field survey on December 2, 19 94, do hereby certify that under requirements of P.A. 74, Michigan P.A. of 1970, the corner points mentioned in lines 1 and 2 above were in conformance with regulations and rules therefore as required in the current manual of survey instructions of the United States Department of the Interior, Bureau of Land Management or by a decree of a Court of Law and/or that the corner points mentioned in lines 3, 4 and 5 above were in conformance with the rules of the Michigan Board of Land Surveyors or by a Decree of a Court of Law; established, re-established, monumented, re-monumented, recovered, found as expressed below:

**NOTE: Not more than 4 corners, all in the same town and range, may be recorded on this certificate.**

	A	B	C	D	E	F	G	H	I	J	K	L	M
2	6	5	4	3	2	1							
3													
4	7	8	9	10	11	12							
5													
6	18	17	16	15	14	13							
7													
8	19	20	21	22	23	24							
9													
10	30	29	28	27	26	25							
11													
12	31	32	33	34	35	36							
13													

**A. Description of original monument and accessories and/or subsequent restoration:**

L-13 South  $\frac{1}{4}$  corner of Section 36, Wright Twp.  
Original Government Corner Record: L.C.R.C. recorded in Liber 2, Page 479, 5-14-74  
Set qr sec post on South side Sec. 36 Fd. Round iron  
Post Solid iron (N  $\frac{1}{4}$  cor., Sec 1) E 58.97'  
Beech 18 N62E 38 Nail in P. Pole ESE 91.90'  
Lynn 7 N64W 41 Nail in P. Pole ENE 54.79'  
Noah Brookfield, Deputy Surveyor Nail in 9" Tree NW 73.63'  
April 12, 1837 C/L B.T. 2.9' North

**B. Description of corner evidence found and/or method applied in restoring or reestablishing corner:**


L-13 Found  $\frac{1}{2}$ " i.d. X 18" Iron Pipe, leaning at surface. Adjusted to best fit existing witnesses, and accepted as a careful and faithful perpetuation of the position of the original corner.

1" o.d. Pinched Pipe	S88°E	58.95'
Found PK nail in West side of Power Pole	S49°30'E	91.89'
Found nail in North side of Power Pole	S49°30'E	91.86'
Found 2 nails in NW side of 24" Elm	S58°W	63.91'
Found PK nail in SW side of 15" stump	N64°W	73.61'
Centerline B.T. road, 2.9' North		

P.A. 345 OTTAWA COUNTY

PEER APPROVED 12/12/94

*Handwritten signature: Audrey P. Medeiros*

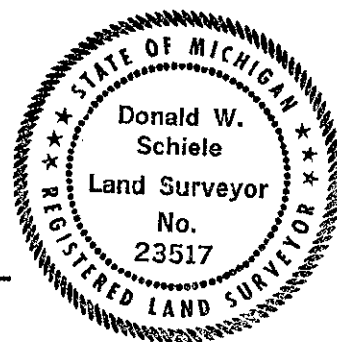

**C. Description of monument for corner and accessories established to perpetuate locating the position of the corner:**

L-13 Removed  $\frac{1}{2}$ " i.d. X 18" Iron Pipe and replaced with  $\frac{3}{4}$ " X 24" Steel Bar with Ottawa County Remon Cap, 2" below surface in Monument Box.  
Set Ottawa County Remon Tag & nail in SE side of 6" Elm N46°E 41.27'  
1" o.d. Pinched Pipe S88°E 58.95'  
Set Ottawa County Remon Tag & nail in NE side of Power Pole S49°30'E 92.17'  
Set Ottawa County Remon Tag & nail in NW side of 24" Elm S58°W 63.62'  
Set Ottawa County Remon Tag & nail in SW side of 22" Elm N69°W 85.76'  
Centerline asphalt road East & West, 2.9' North

Signed by

*Donald W. Schiele*

Date

DEC. 12, 1994

Surveyor's Michigan License No.

23517