

**OTTAWA COUNTY REMONUMENTATION
LAND CORNER RECORDATION CERTIFICATE
Filing Requirement of Act 74, Mich. P.A. 1970**

For corners in

<u>Ottawa</u> <small>(County)</small>	Located In:	Corner Code ##
1. Public Land Survey	T <u>8N</u> R <u>13W</u>	<u>M-6 (E$\frac{1}{4}$, 13)</u> <u>Wright Twp.</u>
	T _____ R _____	_____
	T _____ R _____	_____
	T _____ R _____	_____
2. Property Controlling in Section	S _____ T _____ R _____	_____
	S _____ T _____ R _____	_____
3. Miscellaneous Property in Sec.	S _____ T _____ R _____	_____
	S _____ T _____ R _____	_____

RECORDED

96 DEC 17 AM 10:43

Richard D. Williams
REGISTER OF DEEDS
OTTAWA COUNTY, MI

Register of Deeds Stamp & File Number

4. Lot No. _____, Recorded Plat _____
5. Private Claims _____

I, Donald W. Schiele, in a field survey on November 4, 19 96, do hereby certify that under requirements of P.A. 74, Michigan P.A. of 1970, the corner points mentioned in lines 1 and 2 above were in conformance with regulations and rules therefore as required in the current manual of survey instructions of the United States Department of the Interior, Bureau of Land Management or by a decree of a Court of Law and/or that the corner points mentioned in lines 3, 4 and 5 above were in conformance with the rules of the Michigan Board of Land Surveyors or by a Decree of a Court of Law; established, re-established, monumented, re-monumented, recovered, found as expressed below:

A	B	C	D	E	F	G	H	I	J	K	L	M
2	6	5	4	3	2	1						
3												
4	7	8	9	10	11	12						
5												
6	18	17	16	15	14	13						
7												
8	19	20	21	22	23	24						
9												
10	30	29	28	27	26	25						
11												
12	31	32	33	34	35	36						
13												

NOTE: Not more than 4 corners, all in the same town and range, may be recorded on this certificate.

A. Description of original monument and accessories and/or subsequent restoration:

M-6 $\frac{1}{4}$ corner common to Section 13, Wright Twp. and Section 18, Alpine Twp., Kent Co.
Original Government Corner Record: Ottawa County Surveyor Records: K.C. wit. map 1935
Set qr sec post on East side Sec 13 Stone Conc. Mon.
Post 8" Apple NE 58.3'
Beech 28 S36W 34 Tel. pole SW 54.2'
Do 10 N31W 44 24" Elm NW 35.5'
Noah Brookfield, Deputy Surveyor (SEE REVERSE) 30" Basswood NW 84.3'
April 26, 1837 1967 Conc. Mon.
30" Beech WNW 90.9'
10" Pop. N 60.86'
P.P. ENE 118.3'


B. Description of corner evidence found and/or method applied in restoring or reestablishing corner:

M-6 Found Cast Iron Monument inscribed "Kent County Monument", encased in concrete at asphalt surface, and accepted as a careful and faithful perpetuation of the position of the original corner.
Found nail in West side of Power Pole N79°30'E 118.16' (E)
Found Kent County Remon Tag & nail in SW side of dead 30" Beech N54°00'W 91.70' (E)
Found Kent County Remon Tag & nail in NE side of 14" Twin Oak N30°00'W 56.30' (E)
Centerline dead 36" Basswood N07°00'W 85.6' (E)
Found Kent County Remon Tag & nail in East side of 18" Poplar N03°00'W 60.78' (E)

P.A. 345 OTTAWA COUNTY
PEER APPROVED 11-11-96

C. Description of monument for corner and accessories established to perpetuate locating the position of the corner:

M-6 Cast Iron Monument inscribed "Kent County Monument", encased in concrete at asphalt surface.
Set Ottawa County Remon Tag & nail in South side of Power Pole N79°30'E 118.70' (E) \$ 1.00
Set Ottawa County Remon Tag & nail in South side of 22" Oak N68°30'W 99.88' (E) \$ 1.00
Set Ottawa County Remon Tag & nail in NE side of 14" Twin Oak N30°00'W 56.03' (E) \$ 1.00
Set Ottawa County Remon Tag & nail in East side of 18" Poplar N03°00'W 60.97' (E) \$ 11.00
Centerline old fence North, 3' West
On occupation line South
Centerline East & West asphalt road, 0.5' South

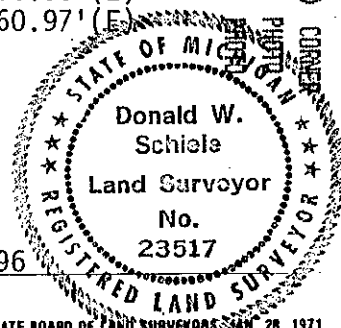

Signed by Donald W. Schiele

Date November 8, 1996

Surveyor's Michigan License No. 23517

Part A., continued:

M-6

W & W 1967 Conc. Mon.
on C/L E & W Rd.
& fence line N.
wit. same as K.C.
map 1967

Ottawa Co.
E ¼ 13, 8-13
Conc. Mon.
same as K.C.
wit. map 1935

L.C.R.C. recorded in
Kent County Filing # 4321: 12-27-85:
A-6 Replaced conc. mon. with std. K.C. Mon.
(Harrison 4" x 30") 6" below grade
K.C. Remon. tag & nail in
E. side 14" Poplar N 0° E 61.23'
K.C. Remon. tag & nail in
E. side 12" Oak N 25° W 56.70'
K.C. Remon tag & nail in
SW side 36" Beech N 50° W 91.84'
PK nail in N. side 16" Apple S 60° E 66.88'
Nail in face of Power pole N 70° E 118.34'

L.C.R.C. recorded in

Kent County Filing # 5732: 1-18-91:

A-6 Set Std. K.C. Mon. 4" x 30" (replaced PK nail)

Nail & remon. tag in E side 16" Poplar N 0° E 61.23'

Nail & remon. tag in E side 12" Oak N 25° W 56.27' (4.5' high)

Nail & remon. tag in SW side 36" Beech N 50° W 91.84'

Nail in face of P. pole N 70° E 118.34'

On C/L blacktop E-W