

**OTTAWA COUNTY REMONUMENTATION  
LAND CORNER RECORDATION CERTIFICATE  
Filing Requirement of Act 74, Mich. P.A. 1970**

For corners in

<u>Ottawa</u> <small>(County)</small>	Located In:	Corner Code #
1. Public Land Survey	T <u>8N</u> R <u>13W</u>	<u>M-12 (E<math>\frac{1}{4}</math>, 36)</u> <u>Wright Twp.</u>
	T _____ R _____	_____
	T _____ R _____	_____
	T _____ R _____	_____
2. Property Controlling in Section	S _____ T _____ R _____	_____
	S _____ T _____ R _____	_____
3. Miscellaneous Property in Sec.	S _____ T _____ R _____	_____
	S _____ T _____ R _____	_____

**RECORDED**

96 DEC 17 AM 10:43

*Deborah A. Johnson*  
REGISTER OF DEEDS  
OTTAWA COUNTY, MI

**Register of Deeds Stamp & File Number**

4. Lot No. \_\_\_\_\_, Recorded Plat \_\_\_\_\_  
5. Private Claims \_\_\_\_\_

A	B	C	D	E	F	G	H	I	J	K	L	M
2	6	5	4	3	2	1						
3												
4	7	8	9	10	11	12						
5												
6	18	17	16	15	14	13						
7												
8	19	20	21	22	23	24						
9												
10	30	29	28	27	26	25						
11												
12	31	32	33	34	35	36						
13												

I, Donald W. Schiele, in a field survey on November 5, 19 96, do hereby certify that under requirements of P.A. 74, Michigan P.A. of 1970, the corner points mentioned in lines 1 and 2 above were in conformance with regulations and rules therefore as required in the current manual of survey instructions of the United States Department of the Interior, Bureau of Land Management or by a decree of a Court of Law and/or that the corner points mentioned in lines 3, 4 and 5 above were in conformance with the rules of the Michigan Board of Land Surveyors or by a Decree of a Court of Law; established, re-established, monumented, re-monumented, recovered, found as expressed below:

**NOTE: Not more than 4 corners, all in the same town and range, may be recorded on this certificate.**

A. Description of original monument and accessories and/or subsequent restoration:

M-12  $\frac{1}{4}$  corner common to Section 36, Wright Twp. and Section 31, Alpine Twp., Kent Co.  
Original Government Corner Record: L.C.R.C. recorded in Liber 5, Page 4, 10-15-82  
Set qr sec post on East side Sec. 36 Set C.I.M.  
Post 8" Maple NNW 89.60'  
Tam 10 S52W 98 Power Pole NW 58.63' (SEE REVERSE)  
Do 10 N54W 1.20 Power Pole SW 61.18'  
Noah Brookfield, Deputy Surveyor St. Sign E 26.21'  
April 26, 1837 (Note: This L.C.R.C. filed for incorrect location)


B. Description of corner evidence found and/or method applied in restoring or reestablishing corner:

M-12 Found Cast Iron Monument inscribed "Kent Co. Monument, T8N R12W" at ground level and accepted as a careful and faithful perpetuation of the position of the original corner.  
Found Kent County Remon Tag & nail in West side of dead 12" Elm N11°00'E 86.30'  
Found Kent County Remon Tag & nail in South side of 8" Beech N85°00'E 43.55'  
Found Kent County Remon Tag & nail in NE side of 18" Elm S46°00'E 53.54'  
Found Kent County Remon Tag & nail in SE side of 16" Elm S64°00'W 39.79'  
Found Kent County Remon Tag & nail in North side of 7" Elm N73°00'W 35.73'

PEER APPROVED 11-11-96

C. Description of monument for corner and accessories established to perpetuate locating the position of the corner:

M-12 Cast Iron Monument inscribed "Kent Co. Monument, T8N R12W" at ground level.  
Set Ottawa County Remon Tag & nail in NW side of 14" Oak N57°00'E 59.60'  
Set Ottawa County Remon Tag & nail in NE side of 18" Elm S46°00'E 53.63'  
Set Ottawa County Remon Tag & nail in SE side of 16" Elm S64°00'W 39.79'  
Set Ottawa County Remon Tag & nail in North side of 7" Elm N73°00'W 35.83'  
Found remnants of old fence going East  
North & South fence line remnants, 30'± East

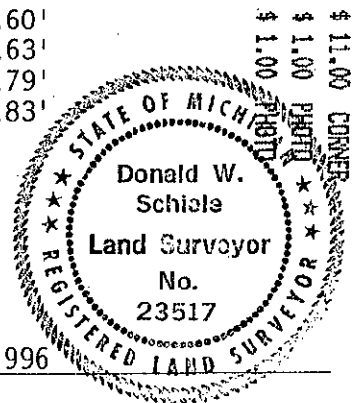

Signed by Donald W. Schiele Date November 11, 1996  
Surveyor's Michigan License No. 23517

Part A., continued:

M-12

K.C. wit. map	W & W
1935 Buggy Axle	1885 stake
8" Elm NE 21.0'	mea. N. 2527'
dbl. 8" Elm ESE 16.8'	mea. S. 2530'
8" Elm SE 83.5'	
24" Basswood ENE 46.0'	

L.C.R.C. recorded in Kent County Filing # 4408, 5-22-86:

A-12 Replaced buggy axle with std. K.C. Mon. (Harrison 4" x 30")

K.C. Remon. tag & nail in W. side	12" Elm	N 15° E	86.38'
K.C. Remon. tag & nail in E. side	10" Elm	S 55° W	39.62'
K.C. Remon. tag & nail in N. side	10" Elm	S 40° E	53.85'
K.C. Remon. tag & nail in S. side	8" Beech	N 90° E	43.65'