

**OTTAWA COUNTY REMONUMENTATION
LAND CORNER RECORDATION CERTIFICATE
Filing Requirement of Act 74, Mich. P.A. 1970**

RECORDED

96 DEC 18 PM 4: 55

Philip B. Holman
REGISTER OF DEEDS
OTTAWA COUNTY, MI

For corners in

<u>Ottawa</u> (County)	Located In:	Corner Code #
1. Public Land Survey	T <u>8N</u> R <u>13W</u>	<u>M-13 (SE, 36)</u>
	T _____ R _____	<u>Wright Twp.</u>
	T _____ R _____	_____
	T _____ R _____	_____
2. Property Controlling in Section	S _____ T _____ R _____	_____
	S _____ T _____ R _____	_____
3. Miscellaneous Property in Sec.	S _____ T _____ R _____	_____
	S _____ T _____ R _____	_____

Register of Deeds Stamp & File Number

4. Lot No. _____, Recorded Plat _____
5. Private Claims _____

A	B	C	D	E	F	G	H	I	J	K	L	M
2	6	5	4	3	2	1						
3												
4	7	8	9	10	11	12						
5												
6	18	17	16	15	14	13						
7												
8	19	20	21	22	23	24						
9												
10	30	29	28	27	26	25						
11												
12	31	32	33	34	35	36						
13												

I, Donald W. Schiele, in a field survey on November 19, 1996, do hereby certify that under requirements of P.A. 74, Michigan P.A. of 1970, the corner points mentioned in lines 1 and 2 above were in conformance with regulations and rules therefore as required in the current manual of survey instructions of the United States Department of the Interior, Bureau of Land Management or by a decree of a Court of Law and/or that the corner points mentioned in lines 3, 4 and 5 above were in conformance with the rules of the Michigan Board of Land Surveyors or by a Decree of a Court of Law; established, re-established, monumented, re-monumented, recovered, found as expressed below:


NOTE: Not more than 4 corners, all in the same town and range, may be recorded on this certificate.

A. Description of original monument and accessories and/or subsequent restoration:

M-13 SE corner, Section 36, Wright Twp. From Ottawa County Surveyor records (no date):
Original Government Corner Record: Found Stone & Lead
Post cor of Towns 7 and 8 North, Ranges 12 and 13 West
Post
Sugar 12 N82E 40
Beech 12 N79W 30
Noah Brookfield, Deputy Surveyor
April 12, 1837

Maple 14 N1°30'W 25.3
Maple 14 N44°E 35.4
South Fence on Line Post 30'
(MSHD placed pipe on E. side)

(SEE REVERSE)

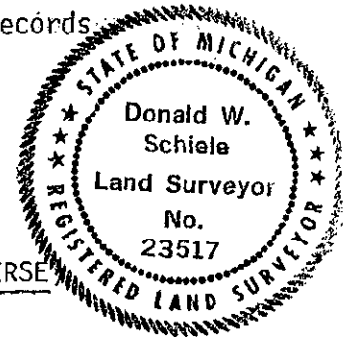

B. Description of corner evidence found and/or method applied in restoring or reestablishing corner:

M-13 Found Cast Iron Monument inscribed "Kent County Monument T7N R12W A1" encased in concrete at level of asphalt pavement, and accepted as a careful and faithful perpetuation of the position of the original corner.

Found chiselled "X" in concrete headwall	N12°30'E	67.44'(E)
Found Kent County Remon Tag & nail in South side of Power Pole	N72°30'E	94.92'(E)
Found Kent County Remon Tag & nail in North side 14" Walnut	S70°30'E	92.73'(E)
Found Kent County Remon Tag & nail in SE side 12" Maple	S40°30'W	41.22'(E)
Found Square Iron Pin in Monument Box	S89°W	65.73'(E)
Found Kent County Remon Tag & nail in SW side 45" Catalpa	N43°30'W	47.05'(E)
Found chiselled "X" in concrete headwall	N10°30'W	67.63'(E)

P.A. 345 OTTAWA COUNTY

PEER APPROVED 12-9-96

C. Description of monument for corner and accessories established to perpetuate locating the position of the corner:

M-13 Cast Iron Monument inscribed "Kent County Monument T7N R12W A1", encased in concrete at level of asphalt pavement.

Chiselled "X" in concrete headwall	N12°30'E	67.44'(E)
Set Ottawa County Remon Tag & nail in South side of Power Pole	N72°30'E	94.97'(E)
Set Ottawa County Remon Tag & nail in North side of 14" Walnut	S70°30'E	92.77'(E)
Set Ottawa County Remon Tag & nail in NW side of 12" Maple	S40°30'W	41.18'(E)
Square Iron Pin in Monument Box	S89°W	65.73'(E)
Set Ottawa County Remon Tag & nail in SW side of 45" Catalpa	N43°30'W	47.05'(E)
Chiselled "X" in concrete headwall	N10°30'W	67.63'(E)

Centerline asphalt road East & West, 2' South
(SEE SKETCH ON REVERSE)

Signed by Donald W. Schiele Date December 7, 1996
Surveyor's Michigan License No. 23517

Part A., continued:

From Tallmadge Township witness sheet, revised Jan., 1966:

Stone & Iron

- 18" Maple NW 25.2'
- Post S 30' to Fence
- 15" Maple NE 36.4'
- 10" Elm N 93.5
- 20" Maple NE 107.1
- 12" Catalpa NW 46.6
- 8" Catalpa WNW 71.0'

L.C.R.C. recorded in Kent County
Filing # 803, 6-23-75:

- Part B: 3/4" Iron
 24" Maple N. 93.95'
 20" Maple E.N.E. 107.65'
 T.P. S.S.W. 35.97'
 24" Catalpa N.W. 47.10'
 1960 - MSHD

- Part C: Found 1/2" Bar 2.3' North of
 Centerline 4 Mile Road, 32'
 East of Tree Line to North
 Found Nail - South Side Power Pole Az. 74° 94.66'
 Found Nail - East Side 32" Elder Az. 341° 46.36'
 Found Nail - Northeast Side 18" Elder Az. 351° 77.09'

L.C.R.C. recorded in Kent County
Filing # 3166, 12-17-82:

- Part B: A-1 Found 3/4" iron & 2 boat spikes angled over top of large leaded stone
 (14" below grade). Top of iron 0.37' East of lead plug in stone.
 Found by all the witnesses listed in "A" above for L.C.R.C. #803
 (32" Elder is a Catalpa)
 MSHD - 1960 - All witnesses gone except for the Catalpa NW, checks O.K.

- Part C: A-1 Set 4"x12" std. K.C. monument in pavement over lead plug in stone.
 Remon tag on S side p. pole N75°E 95.0'
 Remon tag on SW side 40" Catalpa N40°W 47.04'
 " " " SE side 3" Maple S45°W 41.3'
 Set chisled "X" on C/L H/W N10°W 67.58'
 Set chisled "X" on C/L H/W N15°E 67.45'
 Iron in Ottawa Co. mon. box west 65.75'
 C/L E-W pavt. 1.7' S

L.C.R.C. recorded in Kent County
Filing # 7268, 11-28-94:

- A-1 Standard Kent County Monument
 Nail & KC Remon. tag S. side P. Pole N75°E 94.91'
 New Nail & KC Remon. tag SW side 44" Catalpa N40°W 47.08'
 New Nail & KC Remon. tag SE side 6" Maple S45°W 41.31'
 Chiseled "X" on C/L H/W N10°W 67.45'
 Chiseled "X" on C/L H/w N15°E 67.40'
 Iron in Ottawa Co. mon. box West 65.75'
 Set Nail & KC Remon. tag N. side 14" Tree S65°E 92.78'
 C/L pavement is 1.7' South

