

FEB 24 2000

RECORDED

99 SEP 23 PM 3: 21

SECTION

OTTAWA COUNTY REMONUMENTATION
LAND CORNER RECORDATION CERTIFICATE
Filing Requirement of Act 74, Mich. P.A. 1970

[Signature]
REGISTER OF DEEDS
OTTAWA COUNTY, MI

For corners in

<u>Ottawa</u> (County)	Located In: Polkton Twp.	Corner Code # A-1
1. Public Land Survey	T8N R14W	NW corner
	T___ R___	Section 6
	T___ R___	
	T___ R___	
2. Property Controlling in Section	S___ T___ R___	
	S___ T___ R___	
3. Miscellaneous Property in Sec.	S___ T___ R___	
	S___ T___ R___	

Register of Deeds Stamp & File Number

4. Lot No. _____, Recorded Plat _____
5. Private Claims _____

I, Carl P. Englert, in a field survey on 5/28, 1999 do hereby state that under requirements of P.A. 74, Michigan P.A. of 1970, the corner points mentioned in lines 1 and 2 above were in conformance with regulations and rules therefore as required in the current manual of survey instructions of the United States Department of the Interior, Bureau of Land Management or by a decree of a Court of Law and /or that the corner points mentioned in lines 3, 4 and 5 above were in conformance with the rules of the Michigan Board of Land Surveyors or by a Decree of a Court of Law; established, re-established, monumented, recovered, found as expressed below:

NOTE: Not more than 2 corners, all in the same town and range, may be recorded on this certificate.

A	B	C	D	E	F	G	H	I	J	K	L
1											
2	6		5		4		3		2		1
3											
4	7		8		9		10		11		12
5											
6	18		17		16		15		14		13
7											
8	19		20		21		22		23		24
9											
10	30		29		28		27		26		25
11											
12	31		32		33		34		35		36
13											

A. Description of original monument and accessories and/or subsequent restoration:

A-1 Corner common to Towns 8 and 9N, Ranges 14 and ~~13~~W.
 John Mullett D.S. 1837 LCRC Liber 2, Page 253, Englert 8/1973
 Post Found Iron Stake
 Hemlock 22" S57°W 34 Links W 33.0' Cherry
 Hemlock 18" N 8°W 28 Links SE 82.31' 8" Cherry
 LCRC Liber 2, Page 423, Englert 11/1973
 Found 3/4" Pipe
 Ties same as Liber 2, Page 253

B. Description of corner evidence found and/or method applied in restoring or reestablishing corner:

A-1 Found 4" Harrison Cast Iron Monument 0.3' Below Grade in Center of Gravel Road East
 5'± West of Gravel Road North and South, Fence line West,
 0.3' Below Grade
 Found triple Cherry S60°W 28'± (No nail)
 Record dimension checks North, ~~South~~ and East
 Accepted as a careful and faithful perpetuation of the original position of the corner.


C. Description of monument for corner and accessories established to perpetuate locating the position of the corner:

A-1 4" Harrison Cast Iron Monument
 O.C. Remon Nail and Tag in NW Side Power Pole N61°E 190.19'
 O.C. Remon Nail and Tag in NE Side Power Pole S45°E 259.06'
 O.C. Remon Nail and Tag in S Side 15" Cherry N82°W 32.98'
 O.C. Remon Nail and Tag in SE Side Triple 15" Cherry S60°W 30.28'
 O.C. Remon Nail and Tag in E Side 14" Black Locust N24°W 77.62'

9/13/99
[Signature]
 \$11.00 CORNER
 Receipt #58
 Receipt #58324

Signed by Carl P. Englert
Surveyor's Michigan License No. 18987

Date 8/30/1999

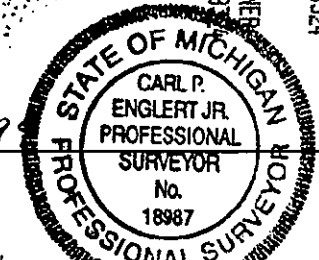

FEB 24 2000

SECTION

A-1 T8N, R15W

LCRC Liber 4, Page 97, Joiner August, 1980

Found Iron Stake, Set Cast Iron Monument, inscribed Sec. Corner

Triple 13" Cherry SW 27.88'

14" Cherry WNW 32.57'

Street Sign SE 44.64'

LCRC Muskegon County, Liber 1242, Page 316

SW Corner Section 31, T9N, R14W

Found Cast Iron Monument

S64°W 27.87' 14" Triple Cherry

West 33.16' 16" Cherry

LCRC Liber 1810, Page 556, Muskegon County Remon. Records,

Recorded as M-13, T9N, R15W, December 1994

Found 4" Cast Iron Monument

Ties do not fit corner.

