## OTTAWA COUNTY REMONUMENTATION 99 DEC -2 PH 1: 13


SE			ħ.
3.7	L a f	88 #	11

LAND CORNER RECORDATION CERTIFICATE
Filing Requirement of Act 74, Mich. P.A. 1970

SECTION	LAND CO Filing R	ORNER RECORD/ Requirement of Act	ATION CERTIFI 74, Mich. P.A.	1970	Jong .		•	
or corners in	`		ì		REGISTE	R OF DEEDS		
OTTAWA (County)	Located In:	Corner Code#			OTTANK	िक्षेत्र <b>मा</b>		
Public Land Survey     Property Controlling	T <sup>8N</sup> R_14 TR TR S TR S TR	A-3 NW cor Section 7, F	ner Polkton	Sog.	a)			
in Section	S T R							
3. Miscellaneous Property in Sec.	s tR_			R	egister of	Deeds Star	np & File I	<u>lumber</u>
4. Lot No, Records	d Plat			1 A	всг	E F G	HIJ	K L M
5. Private Claims			<del></del>	2	-6	5	-3-1-2	-+-}-
Randai J. Vugteveen I, requirements of P.A. 74, Michigan I conformance with regulations and ru United States Department of the Inte that the corner points mentioned in Board of Land Surveyors or by a recovered, found as expressed below	erior, Bureau of Land Mar lines 3, 4 and 5 above w Decree of a Court of	in the current manual of a	survey instructions of of a Court of Law and the rules of the Michie	the 5	-18	8		12-
NOTE: Not more than 2 come on this certificate.	rs, all in the same town			10- 11- 12- 13		3233	34 3	536
A. Description of original mon A-3 Liber 2, Page 478 Remonumer Comer Common to Sections 6 & 7 Sections 1 & 12, T8N, R15W 4" CIM Nail & Remon Tag in W side 26" S 53.03' Nail & Remon Tag in E side P. Po Nail & Remon Tag in E side P. Po Nail & Remon Tag in S side P. Po Nail & Remon Tag in S side P. Po B. Description of corner evid	tation approved October, T8N, R14W & Spruce N39°E  le S15°W 119.95' le N10°W 185.52' le N78°E 246.08' le noce found and/or me	ethod applied in restor		ng corner:				
A-3 Found 3/4" X 36" steel bar wit	th Ottawa County Remo	n Cap in Gravel Road						
Found Nail & Remon Tag in W sk N40°E 53.01' Found Nail & Remon Tag in E sid 185.44' Found Nail & Remon Tag in E sid 119.93'	fait le P. Pole N10°W	cepted Bar with Remon thful perpetuation of the rner.	Cap as a careful an position of the origin	d nal		1/15	199 M	
	•	ensing actablished to n	nerpetuate locating	the position	on of the o	corner:		
C. Description of monument		soues esignistien in h	Ani haraman tanan 19	•	\$ 4		·	
A-3 3/4" X 36" Iron Bar with O.C	. Remon Cap					RANDALL		XB CI
Corner common to M-3 Crocken Found Nail & Remon Tag in W s Found Nail & Remon Tag in E s Found Nail & Remon Tag in E s Capped iron bar witness S45°W	side 28" Spruce N40 E 3 ide Power Pole N10°W ide Power Pole S15°W (68.80'	119.93'			C. C. C.	VUGTEVEEN NO. 28429		Receirt #64%
On centerline "X" gravel road (to	be paved October 2).	1992)		<u>~</u>	₹ <sub>5</sub> ,	Mossagery And	1499	<b>,</b>
	1 1/1/	_		AT 1			, -, -, -, -,	

Date October 27, 1999

SECTION

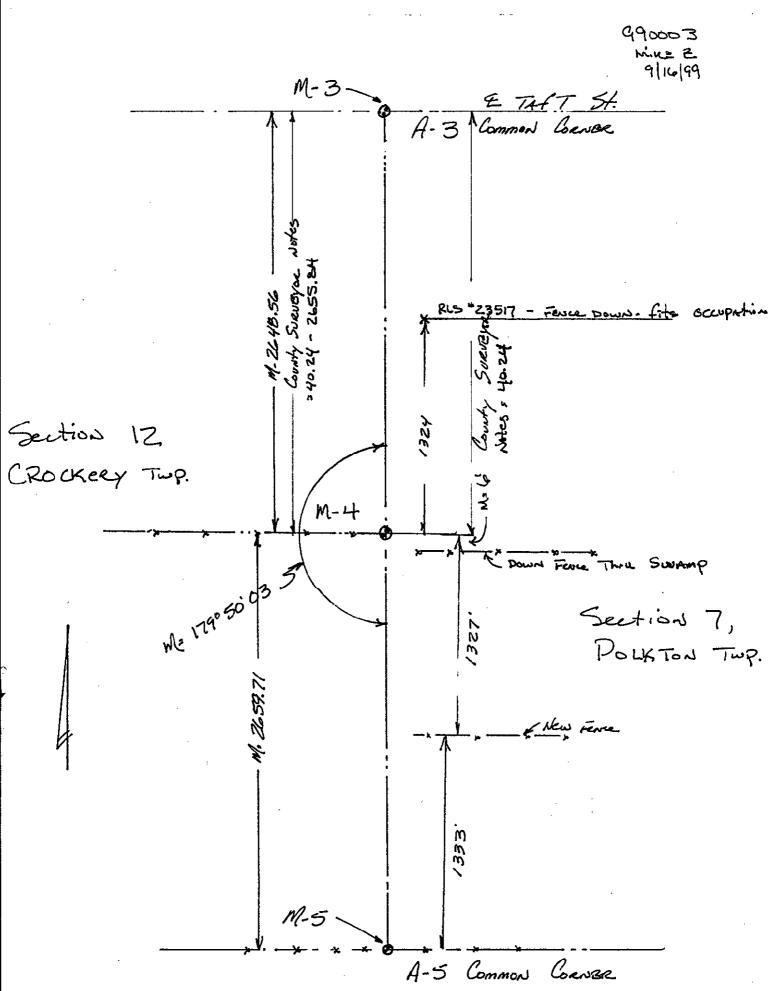

Liber 4 Page 530