

FEB 24 2000

RECORDED

SECTION

OTTAWA COUNTY REMONUMENTATION
LAND CORNER RECORDATION CERTIFICATE
Filing Requirement of Act 74, Mich. P.A. 1970

99 SEP 23 PM 3: 22

For corners in

<u>Ottawa</u> (County)	Located In:	Corner Code #
	Polkton Township	
1. Public Land Survey	T <u>8N</u> R <u>14W</u>	<u>A-7</u>
	T ___ R ___	<u>NW corner</u>
	T ___ R ___	<u>Section 19</u>
	T ___ R ___	_____
2. Property Controlling in Section	S ___ T ___ R ___	<u>COMMON CORNER</u>
	S ___ T ___ R ___	<u>TO M-7, T8N, R15W</u>
3. Miscellaneous Property in Sec.	S ___ T ___ R ___	_____
	S ___ T ___ R ___	_____

Sam Mullett
REGISTER OF DEEDS
OTTAWA COUNTY, MI

Register of Deeds Stamp & File Number

4. Lot No. _____, Recorded Plat _____
5. Private Claims _____

I, Carl P. Englert, in a field survey on 6/20, 19 99 do hereby state that under requirements of P.A. 74, Michigan P.A. of 1970, the corner points mentioned in lines 1 and 2 above were in conformance with regulations and rules therefore as required in the current manual of survey instructions of the United States Department of the Interior, Bureau of Land Management or by a decree of a Court of Law and /or that the corner points mentioned in lines 3, 4 and 5 above were in conformance with the rules of the Michigan Board of Land Surveyors or by a Decree of a Court of Law; established, re-established, monumented, recovered, found as expressed below:

NOTE: Not more than 2 corners, all in the same town and range, may be recorded on this certificate.

	A	B	C	D	E	F	G	H	I	J	K	L	M
1													
2	6		5		4		3		2		1		
3													
4	7		8		9		10		11		12		
5													
6	18		17		16		15		14		13		
7													
8	19		20		21		22		23		24		
9													
10	30		29		28		27		26		25		
11													
12	31		32		33		34		35		36		
13													

A. Description of original monument and accessories and/or subsequent restoration:

A-7 Corner common to Sections 13 & 24, T8N, R15W and Sections 18 & 19, T8N, R14W
 G.L.O. Mullett, 1837 County Surveyor's Book
 Set corner Sections 13 & 24 Stone
 Beech 16" S 9°W 24 Links SE 20" Elm 59.8'
 Ironwood 6" N 49°W 20 Links SE 43.3' 37" Maple
 Corner 31.95' N of C.L.

See Other Side

B. Description of corner evidence found and/or method applied in restoring or reestablishing corner:

A-7 Found O.C. Remon Cap in concrete over 4" Harrison Cast Monument in Monument Box
 Found P.P. NW 71.84'
 Centerline of Cleveland Street South 32.0'
 Corner of centerline of 96th Avenue


Accepted as a careful and faithful perpetuation of the original position of the corner.

C. Description of monument for corner and accessories established to perpetuate locating the position of the corner:

A-7 O.C. Remon Cap in concrete over 4" Harrison Cast Iron Monument in Monument Box.
 O.C. Remon Tag & Nail in SW side P.P. N40°W 72.23'
 O.C. Remon Tag & Nail in NE side Cut Off Tel.Pole S15°E 136.16'
 O.C. Remon Tag & Nail in W side Tel.Pole S7°W 174.27'
 Centerline of Cleveland Street, South 32.00'
 O.C. Remon Tag & Nail in Power Pole S32°W 255.43'

Signed by Carl P. Englert
 Surveyor's Michigan License No. 18987

Date 8/13/1999

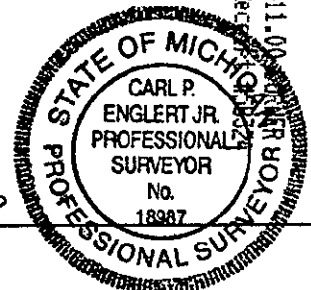

FEB 24 2000

SECTION

A-7, T8N, R15W

LCRC Liber 1, Page 613, Englert, August 1972
Set 5/8" Rod on line with 1/4 corner North and existing
property corners, 31.95 feet North of centerline of
Old U.S.16
NW 72.29' P.P.
S 31.95' to centerline of OLD U.S.16
NE 84.10' to T.P.

LCRC Liber 4, Page 238, Mr. Joiner, October 1981
Found 5/8" Rod, Set Cast Iron Monument
Telephone Pole NNE 84.16'
Power Pole NW 71.84'
Telephone Pole SSE 32.85'
Q, Old U.S.16 South 31.95'

LCRC Liber 4, Page 244, Mr. Joiner, November 1981
Same as Liber 4, Page 238

LCRC Liber 6, Page 245, Mr. Erickson, January 1992
Found Cast Iron Monument in Monument Box
N26°E 82.79' SW corner Telephone Riser Box
S11°E 132.77' Nail & Tag in NW Side Power Pole
N68°W 43.39' SE Face Pipeline Marker Post
N33°W 72.32' N&S in E Side Power Pole
South 31.96' C.L. Cleveland Street