

1893

OTTAWA COUNTY REMONUMENTATION

RECORDED

COMMISSION

LAND CORNER RECORDATION CERTIFICATE

Filing Requirement of Act 74, Mich. P.A. 1970

93 DEC 16 PM 1:01

For corners in

Carl P. Englert Jr.
REGISTER OF DEEDS
OTTAWA COUNTY, MI

<u>Ottawa</u> <small>(County)</small>	Located In:	Corner Code #/
	<u>Polkton Township</u>	
1. Public Land Survey	T <u>8N</u> R <u>14W</u>	<u>A-9</u>
	T _____ R _____	<u>NW Corner</u>
	T _____ R _____	<u>Section 30</u>
	T _____ R _____	_____
2. Property Controlling in Section	S _____ T _____ R _____	_____
	S _____ T _____ R _____	_____
3. Miscellaneous Property in Sec.	S _____ T _____ R _____	_____
	S _____ T _____ R _____	_____

Register of Deeds Stamp & File Number

4. Lot No. _____, Recorded Plat _____
5. Private Claims _____

	A	B	C	D	E	F	G	H	I	J	K	L	M
2	6	5	4	3	2	1							
3													
4	7	8	9	10	11	12							
5													
6	18	17	16	15	14	13							
7													
8	19	20	21	22	23	24							
9													
10	30	29	28	27	26	25							
11													
12	31	32	33	34	35	36							
13													

Carl P. Englert Jr.

I, _____, in a field survey on August 5, 19 93, do hereby certify that under requirements of P.A. 74, Michigan P.A. of 1970, the corner points mentioned in lines 1 and 2 above were in conformance with regulations and rules therefore as required in the current manual of survey instructions of the United States Department of the Interior, Bureau of Land Management or by a decree of a Court of Law and/or that the corner points mentioned in lines 3, 4 and 5 above were in conformance with the rules of the Michigan Board of Land Surveyors or by a Decree of a Court of Law; established, re-established, monumented, re-monumented, recovered, found as expressed below:

NOTE: Not more than 4 corners, all in the same town and range, may be recorded on this certificate.

A. Description of original monument and accessories and/or subsequent restoration:


A-9 L.C.R.C., Liber 6, Pg. 245, (1-25-1993)	L.C.R.C., Liber 4, Pg. 104(10-14-80)
Fd. C.I.M. in Centerline N&S gravel road & 3'± N of centerline of gravel road East	Fd. 1" Iron, Set C.I.M.
N 49 degrees E 46.35' N&S in SE side 8" Oak	6" Cherry, NE 62.21
N 20 degrees W 55.58' N&S in Ne side 12" Maple	9" tree, NW 55.47
S 22 degrees E 24.96' NW cor. Conc. Headwall	Centerline St. Sign, W. 12.51
S 33 degrees W 23.91' NE cor. Conc. Headwall	NW Cor. Conc. Headwall 24.97
N 82 degrees W 12.97' face of N leg signpost	

B. Description of corner evidence found and/or method applied in restoring or reestablishing corner:

A-9 Found 4" Harrison monument 8" deep and accepted as a careful and faithful perpetuation of the position of the original corner.	N 82 degrees W 12.97', face of N. leg of signpost S 22 degrees E 24.96', NW cor. conc headwall S 33 degrees W 23.91', NE cor. conc. headwall N 20 degrees W 55.58', 12" Maple(14" Ash)
---	---

C. Description of monument for corner and accessories established to perpetuate locating the position of the corner:

A-9 4" Harrison cast iron monument
O.C. Remon. Tag & Nail in SE side 5" Oak, N45 degrees E 56.32'
O.C. Remon. Tag & Nail in NE side 14" Ash, N 20 degrees W 55.10'
NW corner of concrete headwall, S 22 degrees E 24.96'
NE corner of concrete headwall, S 33 degrees W 23.91'
Face of N leg of sign post, N 82 degrees W 12.97'

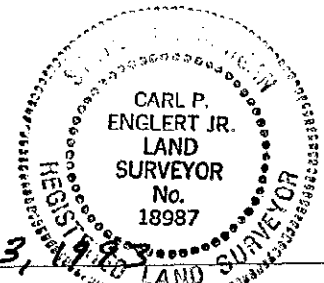

Signed by Carl P. Englert Jr.
Surveyor's Michigan License No. 18987

Date December 3, 1993