

1893

OTTAWA COUNTY REMONUMENTATION

RECORDED

COMMISSION

LAND CORNER RECORDATION CERTIFICATE

93 DEC 16 PM 1:01

Filing Requirement of Act 74, Mich. P.A. 1970

For corners in

Ottawa
(County)

Located In: Polkton Township Corner Code ##

Carl P. Englert Jr.
REGISTER OF DEEDS
OTTAWA COUNTY, MI

- 1. Public Land Survey T 8N R 14W A-10
T _____ R _____ W 1/2 Corner
T _____ R _____ Section 30
T _____ R _____ _____
- 2. Property Controlling S _____ T _____ R _____
in Section S _____ T _____ R _____
- 3. Miscellaneous S _____ T _____ R _____
Property in Sec. S _____ T _____ R _____

Register of Deeds Stamp & File Number

- 4. Lot No. _____, Recorded Plat _____
- 5. Private Claims _____

Carl P. Englert Jr.

I, _____, in a field survey on August 5, 19 93, do hereby certify that under requirements of P.A. 74, Michigan P.A. of 1970, the corner points mentioned in lines 1 and 2 above were in conformance with regulations and rules therefore as required in the current manual of survey instructions of the United States Department of the Interior, Bureau of Land Management or by a decree of a Court of Law and/or that the corner points mentioned in lines 3, 4 and 5 above were in conformance with the rules of the Michigan Board of Land Surveyors or by a Decree of a Court of Law; established, re-established, monumented, re-monumented, recovered, found as expressed below:

NOTE: Not more than 4 corners, all in the same town and range, may be recorded on this certificate.

	A	B	C	D	E	F	G	H	I	J	K	L	M
2	6	5	4	3	2	1							
3													
4	7	8	9	10	11	12							
5													
6	18	17	16	15	14	13							
7													
8	19	20	21	22	23	24							
9													
10	30	29	28	27	26	25							
11													
12	31	32	33	34	35	36							
13													

A. Description of original monument and accessories and/or subsequent restoration:

- A-10
- L.C.R.C., Liber 4, Page 106, (10-14-1980)
- Fd. 1" iron pipe from old ties, Set C.I.M.
- 15" pine, NW 80.80'
- 28" Maple, WNW 27.40'
- P.P., SW 83.65'

B. Description of corner evidence found and/or method applied in restoring or reestablishing corner:


- A-10
- Found 4" Harrison monument with broken top in centerline of gravel road and accepted as a careful and faithful perpetuation of the position of the original corner.
- 30" Maple, WNW 27.40'
- P.P., SW 83.65'
- 15" Pine, NW 80.80'

C. Description of monument for corner and accessories established to perpetuate locating the position of the corner:

- A-10 Replaced broken Harrison monument with 3' long 3/4" iron bar & O.C. Remon. Cap
- O.C. Remon. Tag & Nail in E side 30" Butternut, N 7 degrees W 206.77'
- O.C. Remon. Tag & Nail in NE side 14" Red Pine, N 27 degrees W 88.21'
- O.C. Remon. Tag & Nail in NE side 30" maple, N 72 degrees W 26.99'
- O.C. Remon. Tag & nail in E side P.P., S 50 degrees W 83.78'

Signed by Carl P. Englert Jr.
Surveyor's Michigan License No. 18987

Date December 3, 1993
No. 18987

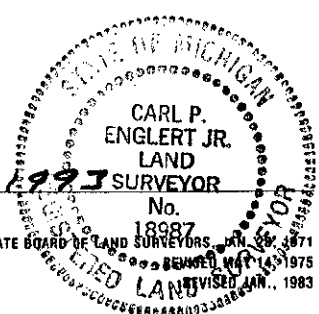

FORM APPROVED BY MICHIGAN STATE BOARD OF LAND SURVEYORS, JAN. 1971
REVISED JAN. 1975
REVISED JAN., 1983