

**OTTAWA COUNTY REMONUMENTATION  
LAND CORNER RECORDATION CERTIFICATE**  
Filing Requirement of Act 74, Mich. P.A. 1970

**RECORDED**  
96 DEC 18 PM 4:56

For corners in

<u>Polkton</u> (County)	Located In:	Corner Code #
	Polkton Township	
1. Public Land Survey	T <u>8N</u> R <u>14W</u>	A-12
	T ___ R ___	West 1/4 corner
	T ___ R ___	Section 31
	T ___ R ___	Common corner
2. Property Controlling in Section	S ___ T ___ R ___	to M-12 Crockery
	S ___ T ___ R ___	Twp. ___
3. Miscellaneous Property in Sec.	S ___ T ___ R ___	___
	S ___ T ___ R ___	___

*Richard R. Hoffman*  
REGISTER OF DEEDS  
OTTAWA COUNTY, MI

Register of Deeds Stamp & File Number

4. Lot No. \_\_\_\_\_, Recorded Plat \_\_\_\_\_  
5. Private Claims \_\_\_\_\_

*Carl P. Englert* in a field survey on 9/3, 19 96 do hereby state that under requirements of P.A. 74, Michigan P.A. of 1970, the corner points mentioned in lines 1 and 2 above were in conformance with regulations and rules therefore as required in the current manual of survey instructions of the United States Department of the Interior, Bureau of Land Management or by a decree of a Court of Law and/or that the corner points mentioned in lines 3, 4 and 5 above were in conformance with the rules of the Michigan Board of Land Surveyors or by a Decree of a Court of Law; established, re-established, monumented, recovered, found as expressed below:

NOTE: Not more than 2 corners, all in the same town and range, may be recorded on this certificate.

	A	B	C	D	E	F	G	H	I	J	K	L	M
1													
2	6		5		4		3		2		1		
3													
4	7		8		9		10		11		12		
5													
6	18		17		16		15		14		13		
7													
8	19		20		21		22		23		24		
9													
10	30		29		28		27		26		25		
11													
12	31		32		33		34		35		36		
13													

A. Description of original monument and accessories and/or subsequent restoration:

A-12 1/4 corner common to Section 31, T8N, R14W & Section 36, T8N, R15W  
G.L.O. Marck 1837 by John Mullett LCRC Liber 1, Page 637 Sept. 1972  
Set 1/4 Section Post from which a Found 1/2" rod  
W. Oak 12" dia. bears S72°W 25 links S. 36" Maple 88.82'  
and a Pine 10" dia. bears N52°W 7 links N.E. 16" Pine 45.52'  
E. P.P. 88.93'  
S.W. P.P. 92.77'

See other side

B. Description of corner evidence found and/or method applied in restoring or reestablishing corner:

A-12 1/4 corner common to Section 31, T8N, R14W & Section 36, T8N, R15W  
Found Cast Iron Monument  
Found P.P. S.W. 92.40'  
Found 16" Pine N.E. 45.52'  
Found P.P. East 88.93'

P.A. 345 OTTAWA COUNTY  
PEER APPROVED 12-9-96

*J.P.M.*


Accepted as a careful and faithful perpetuation of the original position of the corner

C. Description of monument for corner and accessories established to perpetuate locating the position of the corner:

A-12 1/4 corner common to Section 31, T8N, R14W & Section 36, T8N, R15W  
4" Harrison Cast Iron Monument - Placed Monument Box  
O.C. Remon Tag & Nail in E. Side P.P. S49°W 92.67'  
O.C. Remon Tag & Nail in S. Side P.P. N84°E 89.01'  
O.C. Remon Tag & Nail in W. Side 16" Pine N24°E 88.55'  
O.C. Remon Tag & Nail in N.E. Side P.P. N24°W 161.92'

Signed by *Carl P. Englert*  
Surveyor's Michigan License No. 18987

Date December 18, 1996

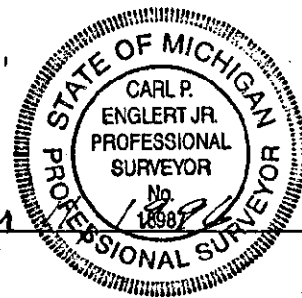

M-12 1/4 corner common to Section 36, T8N, R15W  
and Section 31, T8N, R14W

LCRC Liber 2, Page 75 March 1973

Found Steel Bar at 96th & Leonard

P.P. S.W. 92.40'

16" Pine N.E. 44.75'

St. Sign S.E. 50.20'

T. Pole N.N.E. 43.38'