

RECORDED

96 DEC 18 PM 4:56

OTTAWA COUNTY REMONUMENTATION  
LAND CORNER RECORDATION CERTIFICATE  
Filing Requirement of Act 74, Mich. P.A. 1970

For corners in

*D. P. N.*  
REGISTER OF DEEDS  
OTTAWA COUNTY, MI

<u>Ottawa</u> (County)	Located in:	Corner Code #
	Polkton Township	
1. Public Land Survey	T <u>8N</u> R <u>14W</u>	<u>A-13</u>
	T <u>    </u> R <u>    </u>	<u>SW corner</u>
	T <u>    </u> R <u>    </u>	<u>Section 31</u>
	T <u>    </u> R <u>    </u>	<u>Common corner</u>
2. Property Controlling in Section	S <u>    </u> T <u>    </u> R <u>    </u>	<u>to M-13 Crockery</u>
	S <u>    </u> T <u>    </u> R <u>    </u>	<u>Twp.    </u>
3. Miscellaneous Property in Sec.	S <u>    </u> T <u>    </u> R <u>    </u>	<u>    </u>
	S <u>    </u> T <u>    </u> R <u>    </u>	<u>    </u>

Register of Deeds Stamp & File Number

4. Lot No. \_\_\_\_\_, Recorded Plat \_\_\_\_\_  
5. Private Claims \_\_\_\_\_

I, Carl P. Englert, in a field survey on 9/3, 1996 do hereby state that under requirements of P.A. 74, Michigan P.A. of 1970, the corner points mentioned in lines 1 and 2 above were in conformance with regulations and rules therefore as required in the current manual of survey instructions of the United States Department of the Interior, Bureau of Land Management or by a decree of a Court of Law and/or that the corner points mentioned in lines 3, 4 and 5 above were in conformance with the rules of the Michigan Board of Land Surveyors or by a Decree of a Court of Law, established, re-established, monumented, recovered, found as expressed below:

	A	B	C	D	E	F	G	H	I	J	K	L	M
1													
2	6		5		4		3		2		1		
3													
4	7		8		9		10		11		12		
5													
6	18		17		16		15		14		13		
7													
8	19		20		21		22		23		24		
9													
10	30		29		28		27		26		25		
11													
12	31		32		33		34		35		36		
13													

NOTE: Not more than 2 corners, all in the same town and range, may be recorded on this certificate.

A. Description of original monument and accessories and/or subsequent restoration:

A-13 S.W. Corner Section 31  
 G.L.O. 1837 by John Mullett LCRC Liber 1, Page 637 Sept. 1972  
 Set Post Corner Towns 7 & 8 North Found Concrete Monument  
 and Ranges 14 & 15 West S.W. 12.67' 14" Pine  
 Pine 20" dia. bears S52°E 7 links S.E. 14.47' 18" Pine  
 Hemlock 10" bears N82°W 24 links N.E. 27.46' 4" Cherry

See Other Side

B. Description of corner evidence found and/or method applied in restoring or reestablishing corner:

A-13 S.W. Corner Section 31  
 Found Cast Iron Monument  
 Found S.W. 12.67' 14" Pine  
 Found S.E. 14.47' 8" Pine  
 Found N.E. 27.46' 4" Cherry

P.A. 345 OTTAWA COUNTY  
PEER APPROVED 12-9-96

*D. P. N.*


Accepted as a careful and faithful perpetuation of the original position of the corner.

C. Description of monument for corner and accessories established to perpetuate locating the position of the corner:

A-13 S.W. Corner Section 31  
 4" Harrison Cast Iron Monument 1" deep  
 O.C. Remon tag & nail in E. Side 18" Pine S25°W 12.49'  
 O.C. Remon tag & nail in N. Side 12" Spruce S88°E 19.73'  
 O.C. Remon tag & nail in E. Side 12" Cherry N20°E 27.39'  
 O.C. Remon tag & nail in N.E. Side Tw. 8" Pine N50°W 24.50'

Signed by Carl P. Englert Jr.  
Surveyor's Michigan License No. 18987

Date 11/23/96

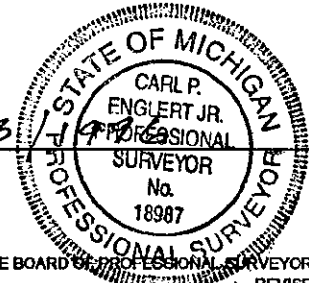

M-13 Section corner common to Section 31, T8N, R14W, Section 36, T8N, R15W, Section 1, T7N, R15W & Section 6, T7N, R14W

LCRC Liber 4, Page 232 Oct. 1981

Set Cast Iron Monument

8" Pine S.E. 14.52'

16" Pine S.W. 12.57'

6" Cherry N.N.E. 27.43'

8" Spruce E.N.E. 22.5'

LCRC Liber 5, Page 317 May 1988

Found C.I. Monument

Found Spike in E. Side 16" Pine S.W. 12.6'

Found Spike in N.E. Side 4" Pine S.E. 14.49'

Found Spike in E. Side 6" W. Cherry N.N.E. 27.44'

Found Spike in S. Side 8" Spruce E.N.E. 22.49'