

FEB 24 2000

RECORDED

99 SEP -9 PM 12: 15

OTTAWA COUNTY REMONUMENTATION
LAND CORNER RECORDATION CERTIFICATE
Filing Requirement of Act 74, Mich. P.A. 1970

Don Schiele
REGISTER OF DEEDS
OTTAWA COUNTY, MI

SECTION
For corners in

Ottawa (County)	Located In:	Corner Code #
1. Public Land Survey	T <u>8N</u> R <u>14W</u>	B-5 (N $\frac{1}{4}$, 18) Polkton Twp.
	T ___ R ___	_____
	T ___ R ___	_____
	T ___ R ___	_____
2. Property Controlling in Section	S ___ T ___ R ___	_____
	S ___ T ___ R ___	_____
3. Miscellaneous Property in Sec.	S ___ T ___ R ___	_____
	S ___ T ___ R ___	_____
4. Lot No. _____, Recorded Plat _____		
5. Private Claims _____		

Register of Deeds Stamp & File Number

I, Donald W. Schiele, in a field survey on Aug. 19, 1999 do hereby state that under requirements of P.A. 74, Michigan P.A. of 1970, the corner points mentioned in lines 1 and 2 above were in conformance with regulations and rules therefore as required in the current manual of survey instructions of the United States Department of the Interior, Bureau of Land Management or by a decree of a Court of Law and/or that the corner points mentioned in lines 3, 4 and 5 above were in conformance with the rules of the Michigan Board of Land Surveyors or by a Decree of a Court of Law; established, re-established, monumented, recovered, found as expressed below:

A	B	C	D	E	F	G	H	I	J	K	L	M
1												
2	6		5		4		3		2		1	
3												
4	7		8		9		10		11		12	
5												
6	18		17		16		15		14		13	
7												
8	19		20		21		22		23		24	
9												
10	30		29		28		27		26		25	
11												
12	31		32		33		34		35		36	
13												

NOTE: Not more than 2 corners, all in the same town and range, may be recorded on this certificate.

A. Description of original monument and accessories and/or subsequent restoration:

B-5 1/4 corner common to Sections 7 & 18, Polkton Twp.

Original Government Corner Record:

Set qr section post
Post

Beech 13 N9W 16

Do 10 S34E 23

John Mullett, Deputy Surveyor

April 15, 1837

L.C.R.C. recorded in L.1, P.419, 6-5-72 by

C.P. Englert, Jr.:

Concrete Mon.

S.W. 24" Maple 46.95

S.E. 8" Twin Cherry 61.46

N.E. To Power Pole 49.73

N. 8" Aspen 12.34

(SEE REVERSE)

B. Description of corner evidence found and/or method applied in restoring or reestablishing corner:


B-5 Found Cast Iron Monument inscribed "Section Corner", 2" above ground level, and accepted as a careful and faithful perpetuation of the position of the original corner.

Found nail in bottle cap in West side of Power Pole N89°E 49.71'(E)

Found nail in SE side of 32" Maple S34°30'W 47.32'(E)

Found nail in East side of 12" Poplar N01°W 12.29'(E)

APPROVED 8/30/99
YD

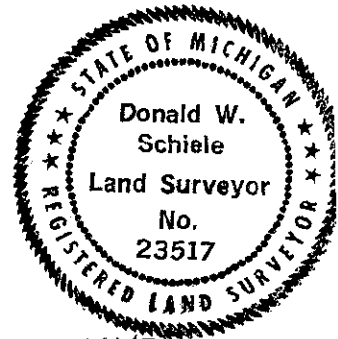

C. Description of monument for corner and accessories established to perpetuate locating the position of the corner:

B-5 Cast Iron Monument inscribed "Section Corner", 2" above ground level.

Set Ottawa County Remon Tag & nail in South side of Power Pole N89°E 50.14'(E)

Set Ottawa County Remon Tag & nail in West side of Triple 6" Maple S22°E 69.81'(E)

Set Ottawa County Remon Tag & nail in SE side of 32" Maple S34°30'W 47.32'(E)

Set Ottawa County Remon Tag & nail in East side of 12" Poplar N01°W 12.26'(E)

Centerline gravel road extended North, 2' East.

Fence corner, North & West fence, 2' North, 1.8' West.

On occupation line to East.

RECEIVED \$11.00 CORNER
RECEIVED \$11.00 PHOTO
RECEIVED \$11.00 PHOTO
RECEIVED \$11.00 PHOTO

Signed by Donald W. Schiele
Surveyor's Michigan License No. 23517

Date August 20, 1999

Part A., continued:

L.C.R.C. recorded in L.4, P.238, 10-22-81 by Thomas E. Joiner:

B-5 Set Cast Iron Monument
Power Pole East 49.80
8" Aspen North 12.34
24" Maple SW 46.89
Tw. 8" Cherry SE 79.79

FEB 24 2000

SECTION

L.C.R.C. recorded in L.4, P.244, 11-4-81 by Thomas E. Joiner:

B-5 Set Cast Iron Monument
Power Pole East 49.80
8" Aspen North 12.34
24" Maple SW 46.89
Tw. 8" Cherry SE 79.79

Certified Survey Map of Ottawa County recorded in L.7, P.313, 12-28-90 by D.W. Schiele:

B-5 Found Cast Iron Monument
11" Aspen North 12.41'
Power Pole East 49.81'
8" Twin Cherry SE 79.79'
32" Maple SW 47.45'