

FEB 24 2000

RECORDED

99 SEP -9 PM 12:15

OTTAWA COUNTY REMONUMENTATION
LAND CORNER RECORDATION CERTIFICATE
Filing Requirement of Act 74, Mich. P.A. 1970

SECTION

For corners in

Ottawa

(County)

Located In:

Corner Code #

1. Public Land Survey

T 8N R 14W

B-9 (N $\frac{1}{4}$, 30)

T R

Polkton Twp.

T R

T R

2. Property Controlling
in Section

S T R

S T R

3. Miscellaneous
Property in Sec.

S T R

S T R

Randy Scholtz

REGISTER OF DEEDS
OTTAWA COUNTY, MI

Register of Deeds Stamp & File Number

4. Lot No. _____, Recorded Plat _____

5. Private Claims _____

I, Donald W. Schiele, in a field survey on Aug. 23, 1999 do hereby state that under requirements of P.A. 74, Michigan P.A. of 1970, the corner points mentioned in lines 1 and 2 above were in conformance with regulations and rules therefore as required in the current manual of survey instructions of the United States Department of the Interior, Bureau of Land Management or by a decree of a Court of Law and/or that the corner points mentioned in lines 3, 4 and 5 above were in conformance with the rules of the Michigan Board of Land Surveyors or by a Decree of a Court of Law; established, re-established, monumented, recovered, found as expressed below:

NOTE: Not more than 2 corners, all in the same town and range, may be recorded on this certificate.


	A	B	C	D	E	F	G	H	I	J	K	L	M
1													
2	6	5	4	3	2	1							
3													
4	7	8	9	10	11	12							
5													
6	18	17	16	15	14	13							
7													
8	19	20	21	22	23	24							
9	●												
10	30	29	28	27	26	25							
11													
12	31	32	33	34	35	36							
13													

A. Description of original monument and accessories and/or subsequent restoration:

B-9 1/4 corner common to Sections 19 & 30, Polkton Twp.
 Original Government Corner Record: L.C.R.C. recorded in L.1, P.623, 8-31-72 by
 Maple 10 qr section corner C.P. Englert, Jr.:
 10" Maple 1 1/2" Iron Bar
 (no other ties taken) E.S.E. 24" Maple 93.85 (SEE REVERSE)
 John Mullett, Deputy Surveyor S.S.E. Fence Post 30.6
 April 14, 1837 S.W. 2nd Fence Post West 58.1

B. Description of corner evidence found and/or method applied in restoring or reestablishing corner:

B-9 Found Cast Iron Monument (broken), 12" below surface of gravel road, and accepted as a careful and faithful perpetuation of the position of the original corner.
 Centerline 24" stump S76°E 94.4' (E)
 Found "PK" nail in East side of Fence Post S31°30'W 35.39' (E)
 Found chiselled "X" on East end of 15" Concrete Culvert N21°W 28.13' (E)

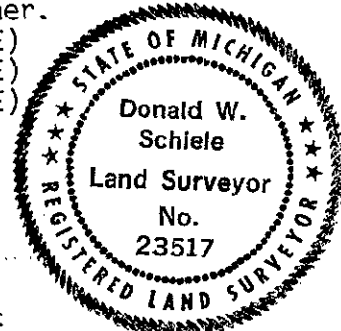

REGISTERED 8/30/99

C. Description of monument for corner and accessories established to perpetuate locating the position of the corner:

B-9 Removed broken Cast Iron Monument and replaced with 3/4" X 36" Steel Bar with Ottawa County Remon Cap, 6" below surface of gravel road.
 Set Ottawa County Remon Tag & nail in East side of 8" Elm N11°30'E 37.77' (E)
 Set Ottawa County Remon Tag & nail in North side of Power Pole S64°E 200.74' (E)
 Set Ottawa County Remon Tag & nail in East side of Fence Post S11°30'E 30.84' (E)
 Set Ottawa County Remon Tag & nail in SE side of Fence Post S31°30'W 35.54' (E)
 Chiselled "X" on East end of 15" Concrete Culvert N21°W 28.13' (E)
 Centerline East & West gravel road, 2' North
 Centerline ditch to North, 3' West
 Fence line to South, 5.2' East

\$2.00 PHOTO
Receipt #56820

\$11.00 CORNER
Receipt #56820

Signed by Donald W. Schiele
Surveyor's Michigan License No. 23517

Date August 24, 1999

Part A., continued:

L.C.R.C. recorded in L.4, P.119, 11-26-80 by Thomas E. Joiner:

B-9 Set Cast Iron Monument
24" Maple ESE 93.91
Fence Post SSE 30.75
1st Fence Post West SW 35.23

L.C.R.C. recorded in L.6, P.244, 1-25-93 by David E. Erickson:

B-9 Cast Iron Monument with Cap Missing
S72E 93.89' N & W in N Side 28" Maple
S06E 31.29' Nail in W Side Cor. Fence Post
S36W 35.32' PK in E Side First Fnc. Post West
N18W 28.09' "+" in E End 18" Conc. Culvert

FEB 24 2000

SECTION