

SURVEY & REMONUMENTATION

FEB 27 1998

OTTAWA COUNTY REMONUMENTATION LAND CORNER RECORDATION CERTIFICATE Filing Requirement of Act 74, Mich. P.A. 1970

For corners in

SECTION

OTTAWA

(County)

Located In:

Corner Code #

- | | | |
|---------------------------------------|--------------------------|--|
| 1. Public Land Survey | T <u>8N</u> R <u>14W</u> | B-13, S 1/4 cor., Sec. 31, Polkton Twp |
| | T ___ R ___ | _____ |
| | T ___ R ___ | _____ |
| | T ___ R ___ | _____ |
| 2. Property Controlling in Section | S ___ T ___ R ___ | _____ |
| | S ___ T ___ R ___ | _____ |
| 3. Miscellaneous Property in Sec. | S ___ T ___ R ___ | _____ |
| | S ___ T ___ R ___ | _____ |

RECORDED

97 DEC -8 AM 11:31

Randal J. Vugteveen
REGISTER OF DEEDS
OTTAWA COUNTY, MI

Register of Deeds Stamp & File Number

4. Lot No. _____, Recorded Plat _____
5. Private Claims _____

I, Randal J. Vugteveen, in a field survey on November 25, 19 97 do hereby state that under requirements of P.A. 74, Michigan P.A. of 1970, the corner points mentioned in lines 1 and 2 above were in conformance with regulations and rules therefore as required in the current manual of survey instructions of the United States Department of the Interior, Bureau of Land Management or by a decree of a Court of Law and /or that the corner points mentioned in lines 3, 4 and 5 above were in conformance with the rules of the Michigan Board of Land Surveyors or by a Decree of a Court of Law; established, re-established, monumented, recovered, found as expressed below:

NOTE: Not more than 2 corners, all in the same town and range, may be recorded on this certificate.

| | A | B | C | D | E | F | G | H | I | J | K | L | M |
|----|----|---|---|----|---|----|---|----|---|----|---|----|---|
| 1 | | | | | | | | | | | | | |
| 2 | 6 | | | 5 | | 4 | | 3 | | 2 | | 1 | |
| 3 | | | | | | | | | | | | | |
| 4 | 7 | | | 8 | | 9 | | 10 | | 11 | | 12 | |
| 5 | | | | | | | | | | | | | |
| 6 | 18 | | | 17 | | 16 | | 15 | | 14 | | 13 | |
| 7 | | | | | | | | | | | | | |
| 8 | 19 | | | 20 | | 21 | | 22 | | 23 | | 24 | |
| 9 | | | | | | | | | | | | | |
| 10 | 30 | | | 29 | | 28 | | 27 | | 26 | | 25 | |
| 11 | | | | | | | | | | | | | |
| 12 | 31 | | | 32 | | 33 | | 34 | | 35 | | 36 | |
| 13 | | | | | | | | | | | | | |

A. Description of original monument and accessories and/or subsequent restoration:

B-13
G.L.O. survey notes
1837 John Mullett
Set post
9" Hemlock N77°E 33 links
9" Hemlock N36°W 24 links

L.C.R.C. Liber 4 Page 89
6-23-80
Found T iron from County Road Commission Records
30" triple Hemlock S25°W 17.29'
26" Oak East 5.95'
20" Oak N50°W 17.62'
22" Oak South 50.82'

B. Description of corner evidence found and/or method applied in restoring or reestablishing corner:

B-13
Found cast iron Ottawa County Monument.
Found nail East side 24" Triple Hemlock AZ 227° 17.25'
Found nail South side 21" Oak AZ 317° 16.93'
Found nail SW side 24" Oak stump AZ 173° 50.81'


Accepted position of cast iron monument as a careful perpetuation of the position of the original corner.

P.A. 345 OTTAWA COUNTY
PEER APPROVED 2/1/97

Randal J. Vugteveen

C. Description of monument for corner and accessories established to perpetuate locating the position of the corner:

B-13
Cast iron Ottawa County Monument
Set Ottawa County Remon tag & nail South side 21" Oak AZ 318° 16.97'
Set Ottawa County Remon tag & nail SE side triple 10" Hemlock AZ 225° 18.22'
Set Ottawa County Remon tag & nail South side 19" Oak AZ 115° 38.66'
Set Ottawa County Remon tag & nail North side power pole AZ 79° 45.33'
Centerline of Leonard Street North +/- 208'

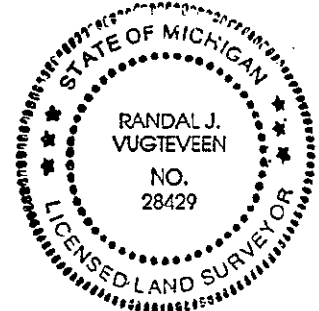

\$ 9.00 CORNER
\$ 1.00 PHOTO

Signed by *Randal J. Vugteveen*
Surveyor's Michigan License No. 28429

Date DEC 1, 1997