

**SURVEY &  
REMONUMENTATION**

APR 24 1995

**COMMISSION**

For corners in

Ottawa  
(County)

Located In:

Corner Code #

- |                                    |   |    |   |     |              |
|------------------------------------|---|----|---|-----|--------------|
| 1. Public Land Survey              | T | 8N | R | 14W | C-3 (NW, 8)  |
|                                    | T |    | R |     | Polkton Twp. |
|                                    | T |    | R |     |              |
|                                    | T |    | R |     |              |
| 2. Property Controlling in Section | S |    | T | R   |              |
|                                    | S |    | T | R   |              |
| 3. Miscellaneous Property in Sec.  | S |    | T | R   |              |
|                                    | S |    | T | R   |              |
4. Lot No. \_\_\_\_\_, Recorded Plat \_\_\_\_\_
5. Private Claims \_\_\_\_\_

RECORDED


94 DEC 14 AM 9:40

*Philip H. Holloman*  
REGISTER OF DEEDS  
OTTAWA COUNTY, MI

Register of Deeds Stamp & File Number

I, Donald W. Schiele, in a field survey on December 10, 19 94, do hereby certify that under requirements of P.A. 74, Michigan P.A. of 1970, the corner points mentioned in lines 1 and 2 above were in conformance with regulations and rules therefore as required in the current manual of survey instructions of the United States Department of the Interior, Bureau of Land Management or by a decree of a Court of Law and/or that the corner points mentioned in lines 3, 4 and 5 above were in conformance with the rules of the Michigan Board of Land Surveyors or by a Decree of a Court of Law; established, re-established, monumented, re-monumented, recovered, found as expressed below:

**NOTE: Not more than 4 corners, all in the same town and range, may be recorded on this certificate.**

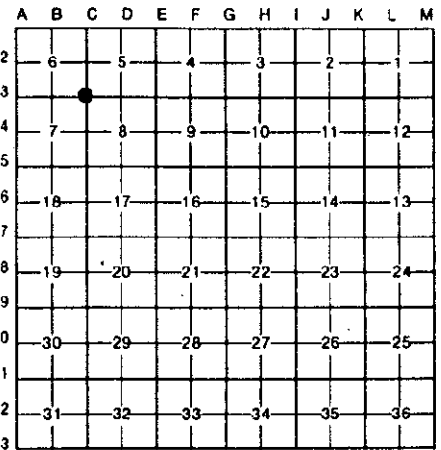

A. Description of original monument and accessories and/or subsequent restoration:  
C-3 corner common to Sections 5, 6, 7 & 8, Polkton Twp.

Original Government Corner Record: L.C.R.C. recorded in Liber 5, Page 109, 6-14-84  
Set corner post Sec. 5, 6, 7, 8 Cast Iron Monument  
Post Telephone Pole NE 40.20'  
Sugar 10 N81E 31 48" Oak ENE 90.95'  
Maple 10 S70W 30 Power Pole SE 114.86'  
John Mullett, Deputy Surveyor 16" Maple WNW 76.89'  
April 15, 1837

B. Description of corner evidence found and/or method applied in restoring or reestablishing corner:

C-3 Found Cast Iron Monument inscribed "Section Corner", 6 1/2" below surface in Monument Box, and accepted as a careful and faithful perpetuation of the position of the original corner.

Found nail in NW side of 52" Oak N70°E 90.94'  
Found nail in NE side of 17" Maple N68°30'W 76.93'

P.A. 345 OTTAWA COUNTY  
PEER APPROVED 12/12/94  
*Madison P. Newbold*



C. Description of monument for corner and accessories established to perpetuate locating the position of the corner:

C-3 Cast Iron Monument inscribed "Section Corner", 6 1/2" below surface in Monument Box.  
Set Ottawa County Remon Tag & nail in SE side of 52" Oak N70°E 90.99'  
Set Ottawa County Remon Tag & nail in SW side of Power Pole S33°E 114.85'  
Set Ottawa County Remon Tag & nail in SW side of 17" Maple N68°30'W 77.11'  
Set Ottawa County Remon Tag & nail in NE side of 8" Spruce N31°W 60.65'  
On centerline gravel road North  
Centerline asphalt road South, 0.4' East  
On centerline gravel road East & West

Signed by Donald W. Schiele Date Dec. 12, 1994  
Surveyor's Michigan License No. 23517