

**SURVEY &
REMONUMENTATION**

APR 24 1995

COMMISSION

OTTAWA COUNTY REMONUMENTATION
LAND CORNER RECORDATION CERTIFICATE
Filing Requirement of Act 74, Mich. P.A. 1970

RECORDED

94 DEC 14 AM 9:40

Deputy Register
REGISTER OF DEEDS
OTTAWA COUNTY, MI

For corners in


Ottawa (County)	Located In:	Corner Code #
1. Public Land Survey	T <u>8N</u> R <u>14W</u>	C-5 (NW, 17) Polkton Twp.
	T _____ R _____	_____
	T _____ R _____	_____
	T _____ R _____	_____
2. Property Controlling in Section	S _____ T _____ R _____	_____
	S _____ T _____ R _____	_____
3. Miscellaneous Property in Sec.	S _____ T _____ R _____	_____
	S _____ T _____ R _____	_____

Register of Deeds Stamp & File Number

4. Lot No. _____, Recorded Plat _____
5. Private Claims _____

I, Donald W. Schiele, in a field survey on December 6, 19 94
do hereby certify that under requirements of P.A. 74, Michigan P.A. of 1970, the corner points mentioned
in lines 1 and 2 above were in conformance with regulations and rules therefore as required in the
current manual of survey instructions of the United States Department of the Interior, Bureau of Land
Management or by a decree of a Court of Law and/or that the corner points mentioned in lines 3, 4 and 5
above were in conformance with the rules of the Michigan Board of Land Surveyors or by a Decree of a
Court of Law; established, re-established, monumented, re-monumented, recovered, found as
expressed below:

**NOTE: Not more than 4 corners, all in the same town and range, may be recorded
on this certificate.**

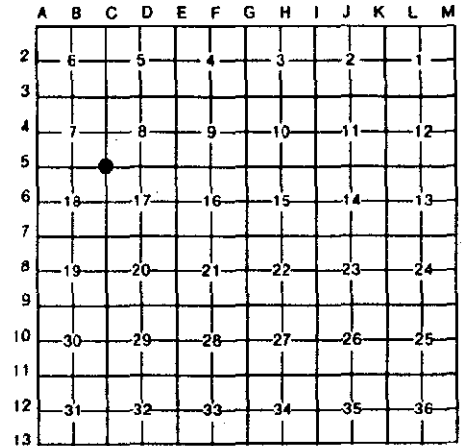


A. Description of original monument and accessories and/or subsequent restoration:
C-5 corner common to Sections 7, 8, 17 & 18, Polkton Twp.
Original Government L.C.R.C. recorded in Liber 1, Page 419, 6-5-72
Corner Record: L.C.R.C. recorded in Liber 5, Page 326, 8-9-88
B Ash 20 corner 5/8" Rod Set CIM
Sections 7, 8, 17, 18 NW Tele. Pole 43.20'
20" B Ash SW 10" Cherry 33.50'
(no ties taken) SSW 14" Ash 67.73'
John Mullett, Deputy Surveyor SSE 15" Ash 79.65'
April 15, 1837

B. Description of corner evidence found and/or method applied in restoring or reestablishing corner:
C-5 Found Cast Iron Monument inscribed "Section Corner", 4 1/2" below surface in Monument Box,
and accepted as a careful and faithful perpetuation of the position of the original
corner.
Found nail in West side of 26" Ash S18°30'E 79.87'
Found nail in South side of 20" Ash S86°W 36.01'

PA. 345 OTTAWA COUNTY
PEER APPROVED 12/12/94

Handwritten signature: Audrey P. Nedewell

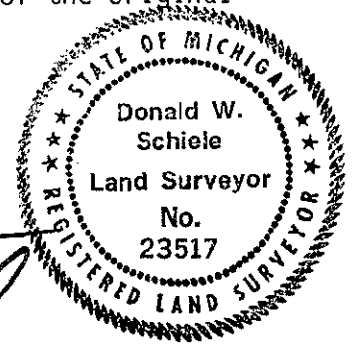

C. Description of monument for corner and accessories established to perpetuate locating the position of the corner:
C-5 Cast Iron Monument inscribed "Section Corner", 4 1/2" below surface in Monument Box.
Set Ottawa County Remon Tag & nail in SW side of 26" Ash S18°30'E 79.96'
Set Ottawa County Remon Tag & nail in SE side of 8" Pine S17°W 110.80'
Set Ottawa County Remon Tag & nail in South side of 20" Ash S86°W 35.89'
SE corner, foundation to House # 17629 N68°W 134.82'
Set Ottawa County Remon Tag & nail in NE side of Power Pole N11°30'W 143.15'
Centerline asphalt road North & South, 0.3' East

Signed by Donald W. Schiele Date DEC. 12, 1994
Surveyor's Michigan License No. 23517