

**SURVEY &
REMONUMENTATION**

APR 24 1995

OTTAWA COUNTY REMONUMENTATION
LAND CORNER RECORDATION CERTIFICATE
Filing Requirement of Act 74, Mich. P.A. 1970

RECORDED

94 DEC 14 AM 9:41


Richard Hallman
REGISTER OF DEEDS
OTTAWA COUNTY, MI

For corners in **COMMISSION**

Ottawa (County)	Located In:	Corner Code #
1. Public Land Survey	T 8N R 14W	C-6 (W $\frac{1}{4}$, 17) Polkton Twp.
	T _____ R _____	_____
	T _____ R _____	_____
2. Property Controlling in Section	S _____ T _____ R _____	_____
	S _____ T _____ R _____	_____
3. Miscellaneous Property in Sec.	S _____ T _____ R _____	_____
	S _____ T _____ R _____	_____

Register of Deeds Stamp & File Number

4. Lot No. _____, Recorded Plat _____
5. Private Claims _____

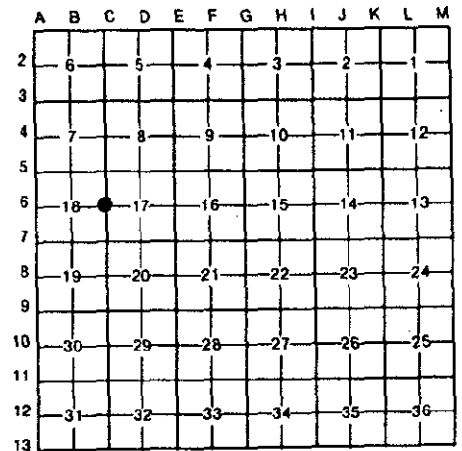

I, Donald W. Schiele, in a field survey on December 10, 19 94
do hereby certify that under requirements of P.A. 74, Michigan P.A. of 1970, the corner points mentioned
in lines 1 and 2 above were in conformance with regulations and rules therefore as required in the
current manual of survey instructions of the United States Department of the Interior, Bureau of Land
Management or by a decree of a Court of Law and/or that the corner points mentioned in lines 3, 4 and 5
above were in conformance with the rules of the Michigan Board of Land Surveyors or by a Decree of a
Court of Law; established, re-established, monumented, re-monumented, recovered, found as
expressed below:

**NOTE: Not more than 4 corners, all in the same town and range, may be recorded
on this certificate.**

A. Description of original monument and accessories and/or subsequent restoration:
C-6 $\frac{1}{4}$ corner common to Sections 17 & 18, Polkton Twp.

Original Government Corner Record: Set qr section post between Sec. 17 & 18 Post Beech 13 S14E 23 Do 9 N58W 34 John Mullett, Deputy Surveyor April 15, 1837	L.C.R.C. recorded in Liber 1, Page 421, 6-5-72 1" Iron Pipe NE Power Pole 49.21' NE Tele. Pole 42.66' SE Power Pole 87.89'	L.C.R.C. recorded in Liber 4, Page 240, 11-4-81 Set Cast Iron Monument Power Pole NNE 49.82' Tele. Pole NE 42.68' Power Pole SE 87.95' Stop Sign SW 41.15'
---	---	--


B. Description of corner evidence found and/or method applied in restoring or reestablishing corner:
C-6 Found Cast Iron Monument inscribed "Section Corner", 6" below surface in Monument Box,
and accepted as a careful and faithful perpetuation of the position of the original
corner.

Found nail & bottle cap in SW side of Power Pole	N35°E	49.19'
Found nail in SE side of Power Pole	N35°E	49.80'
Found nail in SW side of Power Pole	N55°E	42.63'
Found PK nail in NW side of Power Pole	N55°E	43.12'
Found nail in NE side of Power Pole	S19°E	88.40'
Found nail in NW side of Power Pole	S19°E	87.88'
Centerline Stop Sign	S60°W	41.15'
Found nail & washer in SW side of Guy Pole	N26°30'W	61.80'

C. Description of monument for corner and accessories established to perpetuate locating the position of the corner:
C-6 Cast Iron Monument inscribed "Section Corner", 6" below surface in Monument Box.

Set Ottawa County Remon Tag & nail in NW side of Power Pole	N35°E	49.72'
Set Ottawa County Remon Tag & nail in SW side of Power Pole	S19°E	88.43'
Set Ottawa County Remon Tag & nail in SE side of 14" Cherry	S52°W	100.75'
Set Ottawa County Remon Tag & nail in NE side of Guy Pole	N26°30'W	61.71'
Centerline asphalt road North & South, 0.5' East		
On occupation line to East, \pm		
Centerline gravel road SE & NW, 2' SW		

P.A. 345 OTTAWA COUNTY
PEER APPROVED 12/12/94

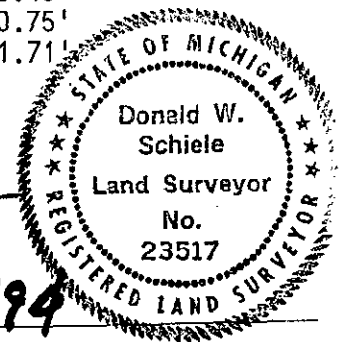

Signed by Donald W. Schiele

Date DEC. 12, 1994

Surveyor's Michigan License No. 23517