

**SURVEY &  
REMONUMENTATION**

OCT 07 1996

**OTTAWA COUNTY REMONUMENTATION  
LAND CORNER RECORDATION CERTIFICATE  
Filing Requirement of Act 74, Mich. P.A. 1970**

For corners in **COMMISSION**

Ottawa (County)	Located In:	Corner Code #
1. Public Land Survey	T 8N R 14W	C-7 (NE, 19) Polkton Twp.
	T _____ R _____	_____
	T _____ R _____	_____
	T _____ R _____	_____
2. Property Controlling in Section	S _____ T _____ R _____	_____
	S _____ T _____ R _____	_____
3. Miscellaneous Property in Sec.	S _____ T _____ R _____	_____
	S _____ T _____ R _____	_____

**RECORDED**

96 AUG 26 PM 2: 03

*Richard Ballman*  
REGISTER OF DEEDS  
OTTAWA COUNTY, MI

Register of Deeds Stamp & File Number

4. Lot No. \_\_\_\_\_, Recorded Plat \_\_\_\_\_  
5. Private Claims \_\_\_\_\_

	A	B	C	D	E	F	G	H	I	J	K	L	M
2	6	5	4	3	2	1							
3													
4	7	8	9	10	11	12							
5													
6	18	17	16	15	14	13							
7		●											
8	19	20	21	22	23	24							
9													
10	30	29	28	27	26	25							
11													
12	31	32	33	34	35	36							
13													

I, Donald W. Schiele, in a field survey on August 20, 19 96  
do hereby certify that under requirements of P.A. 74, Michigan P.A. of 1970, the corner points mentioned in lines 1 and 2 above were in conformance with regulations and rules therefore as required in the current manual of survey instructions of the United States Department of the Interior, Bureau of Land Management or by a decree of a Court of Law and/or that the corner points mentioned in lines 3, 4 and 5 above were in conformance with the rules of the Michigan Board of Land Surveyors or by a Decree of a Court of Law; established, re-established, monumented, re-monumented, recovered, found as expressed below:


**NOTE: Not more than 4 corners, all in the same town and range, may be recorded on this certificate.**

**A. Description of original monument and accessories and/or subsequent restoration:**

C-7 Corner common to Sections 17, 18, 19 & 20, Polkton Twp.  
Original Government Corner Record: L.C.R.C. recorded in Liber 1, Page 421, 5-6-72  
Set post corner secs. 17, 18, 19, 20 (Found) 1" Iron Pipe  
Post  
Beech 8 S55W .08 N.E. Tele. Pole 75.38  
Do 9 N24W .04 N. To South Edge of Metal 1.04  
John Mullett, Deputy Surveyor S.E. To Tele. Pole 58.57  
April 14, 1837 N.W. Gas Line Marker 60.25 (SEE REVERSE)

**B. Description of corner evidence found and/or method applied in restoring or reestablishing corner:**

C-7 Found Cast Iron Monument, 6½" below surface of asphalt pavement, and accepted as a careful and faithful perpetuation of the position of the original corner.  
Found PK nail in East side of Telephone Pole N22°E 75.63'  
Found PK nail in West side of Telephone Pole S30°30'E 58.44'  
Found nail & washer in NW side of Power Pole S34°W 90.84'  
Found PK nail & MSHD tag in SE side of Power Pole S34°W 90.57'  
Centerline, Gas Line Marker N33°30'W 60.59'  
Found nail & washer in SE side of Power Pole N30°30'W 100.13'  
Found nail & washer in NE side of Power Pole N30°30'W 100.52'  
Found PK nail & MSHD tag in SW side of Power Pole N30°30'W 100.46'  
Edge of asphalt, Cleveland Street, 1'± North  
Centerline Cleveland Street, East & West, 11.8' North

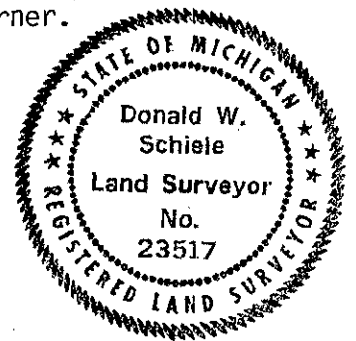

**C. Description of monument for corner and accessories established to perpetuate locating the position of the corner:**

C-7 Placed Monument Box over found Cast Iron Monument, 6½" below surface of asphalt pavement.  
Set Ottawa County Remon Tag & nail in East side of Telephone Pole N22°E 75.65'  
Set Ottawa County Remon Tag & nail in NE side of Telephone Pole S30°30'E 58.68'  
Set Ottawa County Remon Tag & nail in SE side of Power Pole S34°W 90.75'  
Centerline, Gas Line Marker N33°30'W 60.59'  
Set Ottawa County Remon Tag & nail in NE side of Power Pole N30°30'W 100.50'  
Centerline asphalt road North & South, 1.7' West  
Centerline asphalt road East & West, 11.8' North

P.A. 345 OTTAWA COUNTY

PEER APPROVED 8-20-96

Signed by Donald W. Schiele

*Donald W. Schiele*  
Date AUG. 20, 1996

Surveyor's Michigan License No. 23517

Section A., continued:

L.C.R.C. recorded in Liber 5, Page 82, 12-20-83

C-7 Set cast iron monument

TP	NNW	75.27
TP	SE	58.55
PP	SW	90.64
PP	NW	100.50

L.C.R.C. recorded in Liber 6, Page 244, 1-25-93

C-7 Cast Iron Monument

N27W	100.53'	N & W in NE Side Power Pole
N25E	75.65'	PK in E Side Telephone Pole
S27E	58.50'	PK in NW Face Telephone Pole
S38W	90.66'	PK with Tag "MSHD REFMARK" in E Side P.P.
North	11.8'	C/L Cleveland Street

SURVEY &  
REMONUMENTATION

OCT 07 1996

COMMISSION

\* 11.00 CORNER  
\* 1.00 PHOTO  
\* 1.00 PHOTO