

SURVEY & REMONUMENTATION

OCT 24 1994

COMMISSION

**OTTAWA COUNTY REMONUMENTATION
LAND CORNER RECORDATION CERTIFICATE
Filing Requirement of Act 74, Mich. P.A. 1970**

RECORDED

91 OCT -7 PM 12:32

Edythe Holliman
REGISTER OF DEEDS
OTTAWA COUNTY, MI

For corners in

Ottawa (County)	Located In:	Corner Code #
1. Public Land Survey	T <u>8N</u> R <u>14W</u>	<u>C-9 (NW, 29)</u> <u>Polkton Twp.</u>
	T _____ R _____	_____
	T _____ R _____	_____
	T _____ R _____	_____
2. Property Controlling in Section	S _____ T _____ R _____	_____
	S _____ T _____ R _____	_____
3. Miscellaneous Property in Sec.	S _____ T _____ R _____	_____
	S _____ T _____ R _____	_____

Register of Deeds Stamp & File Number

4. Lot No. _____, Recorded Plat _____
5. Private Claims _____

I, Donald W. Schiele, in a field survey on September 13, 19 94, do hereby certify that under requirements of P.A. 74, Michigan P.A. of 1970, the corner points mentioned in lines 1 and 2 above were in conformance with regulations and rules therefore as required in the current manual of survey instructions of the United States Department of the Interior, Bureau of Land Management or by a decree of a Court of Law and/or that the corner points mentioned in lines 3, 4 and 5 above were in conformance with the rules of the Michigan Board of Land Surveyors or by a Decree of a Court of Law, established, re-established, monumented, re-monumented, recovered, found as expressed below:

NOTE: Not more than 4 corners, all in the same town and range, may be recorded on this certificate.

	A	B	C	D	E	F	G	H	I	J	K	L	M
2	6		5		4		3		2		1		
3													
4	7		8		9		10		11		12		
5													
6	16		17		18		19		20		21		22
7													
8	19		20		21		22		23		24		
9													
10	30		29		28		27		26		25		
11													
12	31		32		33		34		35		36		
13													

A. Description of original monument and accessories and/or subsequent restoration:

C-9 corner common to Sections 19, 20, 29 & 30, Polkton Twp.


Original Government Corner Record:	L.C.R.C. recorded in Liber 1, Page 561, 8-21-72	L.C.R.C. recorded in Liber 6, Page 244, 1-25-93
Corner post Sec. 19, 20, 29, 30.	Iron	Cast Iron Monument in Monument Box
Post Beech 8 S57E 07	Q St. Sign SE 38.40'	S53W 45.74' PK in SE Side Telephone Pole
Do. 12 N25W 23	18" Maple WSW 56.95'	N31W 60.05' Nail in W Side Fence Post
John Mullett, Deputy Surveyor	Tel. Pole SW 33.56'	N65E 59.54' SW Cor. Telephone Riser Box
April 14, 1837		S47E 38.46' Face of Street Sign Post

(Also see L.C.R.C. recorded in Liber 4, Page 119, 11-26-80)

B. Description of corner evidence found and/or method applied in restoring or reestablishing corner:

C-9 Found Cast Iron Monument 9" below pavement surface in Monument Box and accepted as a careful and faithful perpetuation of the position of the original corner.

Centerline Telephone Pedestal	N62°30'E	59.61'
SW corner Telephone Pedestal	N62°30'E	59.16'
Found PK nail in SE side of Telephone Pole	S49°30'W	45.73'
Found nail in W side of Fence Post	N34°30'W	60.06'

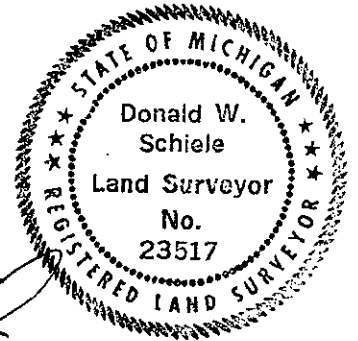

PA. 345 OTTAWA COUNTY

PEER APPROVED 9/17/94

Gordon D. Pedwell

C. Description of monument for corner and accessories established to perpetuate locating the position of the corner:

C-9 Set 3/4" X 6 1/4" solid bar with Ottawa County Remon Cap over Cast Iron Monument in Monument Box. Base of bar set in concrete.

Set Ottawa County Remon Tag & nail in W side of End Fence Post	N21°E	119.23'
Set Ottawa County Remon Tag & nail in N side of Power Pole	S63°E	152.10'
Face of 3" diameter Flag Pole	S46°E	100.81'
Face of 3" diameter Flag Pole	S32°W	106.08'
Set Ottawa County Remon Tag & nail in SE side of Power Pole	S45°W	96.07'
Centerline North & South asphalt road 1.7' East		
Centerline gravel road West 2' North		
On centerline gravel road East		

Signed by Donald W. Schiele Date 9-19-94

Surveyor's Michigan License No. 23517