

**SURVEY & REMONUMENTATION**

OCT 24 1994

COMMISSION

**OTTAWA COUNTY REMONUMENTATION  
LAND CORNER RECORDATION CERTIFICATE  
Filing Requirement of Act 74, Mich. P.A. 1970**

RECORDED

94 OCT -7 PM 12:32

*Richard C. Coleman*  
REGISTER OF DEEDS  
OTTAWA COUNTY, MI


For corners in

Ottawa (County)	Located In:	Corner Code #
1. Public Land Survey	T 8N R 14W	C-10 (W $\frac{1}{4}$ , 29) Polkton Twp.
	T _____ R _____	_____
	T _____ R _____	_____
	T _____ R _____	_____
2. Property Controlling in Section	S _____ T _____ R _____	_____
	S _____ T _____ R _____	_____
3. Miscellaneous Property in Sec.	S _____ T _____ R _____	_____
	S _____ T _____ R _____	_____
4. Lot No. _____, Recorded Plat _____		
5. Private Claims _____		

Register of Deeds Stamp & File Number

I, Donald W. Schiele in a field survey on September 13, 19 94, do hereby certify that under requirements of P.A. 74, Michigan P.A. of 1970, the corner points mentioned in lines 1 and 2 above were in conformance with regulations and rules therefore as required in the current manual of survey instructions of the United States Department of the Interior, Bureau of Land Management or by a decree of a Court of Law and/or that the corner points mentioned in lines 3, 4 and 5 above were in conformance with the rules of the Michigan Board of Land Surveyors or by a Decree of a Court of Law; established, re-established, monumented, re-monumented, recovered, found as expressed below:

**NOTE: Not more than 4 corners, all in the same town and range, may be recorded on this certificate.**

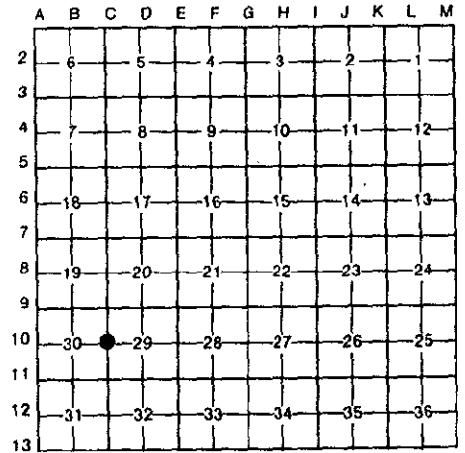

A. Description of original monument and accessories and/or subsequent restoration:  
C-10 corner common to Sections 29 & 30, Polkton Twp.  
Original Government L.C.R.C. recorded in Liber 3, Page 267, 4-24-78  
Corner Record: 1' dia. Stone raised with 1/2" Steel Bar  
Qr section post between sections 29 & 30  
Post Nail in side of 24" Oak  
Pine 22 S49W 21 NE 34.55'  
Maple 10 N32E 27 Nail in side of 14" Poplar  
John Mullett, Deputy Surveyor SSW 116.05'  
April 14, 1837 Nail in side of 16" Maple West 36.80'

L.C.R.C. recorded in Liber 5, Page 174, 12-27-84  
Set C.I.M.  
16" Maple W. 36.76'  
8" Oak WSW. 38.78'  
6" Apple SW. 67.78'  
S. 2606.96' to SE. Cor.


3. Description of corner evidence found and/or method applied in restoring or reestablishing corner:  
C-10 Found Cast Iron Monument inscribed "Section Corner" 5" below surface in Monument Box and accepted as a careful and faithful perpetuation of the position of the original corner.  
Found nail in NW side of 8" Poplar S37°W 67.48'  
Found nail in S side of 14" Oak S81°W 38.77'  
Found nail in S side of 22" Maple S90°W 36.74'

PA. 345 OTTAWA COUNTY

PEER APPROVED 9/19/94

*George P. Nedewick*

3. Description of monument for corner and accessories established to perpetuate locating the position of the corner:  
C-10 Cast Iron Monument inscribed "Section Corner" 5" below surface in Monument Box.  
Set Ottawa County Remon Tag & nail in S side of 9" Cottonwood N90°E 61.80'  
Set Ottawa County Remon Tag & nail in SE side of 6" Birch S37°W 75.85'  
Set Ottawa County Remon Tag & nail in S side of 14" Oak S81°W 38.77'  
Set Ottawa County Remon Tag & nail in S side of 22" Maple S90°W 36.74'  
Centerline North & South asphalt road 0.4' East  
Remnants of old fence lines East & West

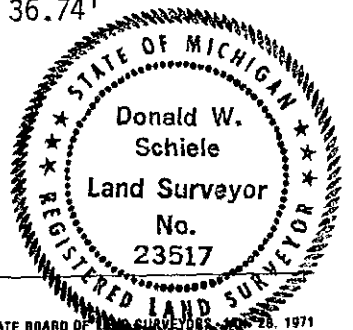

Signed by Donald W. Schiele Date 9-19-94  
Surveyor's Michigan License No. 23517