

SURVEY & REMONUMENTATION

OCT 24 1994

COMMISSION

**OTTAWA COUNTY REMONUMENTATION
LAND CORNER RECORDATION CERTIFICATE
Filing Requirement of Act 74, Mich. P.A. 1970**

RECORDED

91 OCT -7 PM 12:32


For corners in

Ottawa (County)	Located In:	Corner Code #/7
1. Public Land Survey	T <u>8N</u> R <u>14W</u>	<u>C-11 (SW, 29)</u> <u>Polkton Twp.</u>
	T ___ R ___	_____
	T ___ R ___	_____
	T ___ R ___	_____
2. Property Controlling in Section	S ___ T ___ R ___	_____
	S ___ T ___ R ___	_____
3. Miscellaneous Property in Sec.	S ___ T ___ R ___	_____
	S ___ T ___ R ___	_____
4. Lot No. _____, Recorded Plat _____		
5. Private Claims _____		

D. J. ...
REGISTER OF DEEDS
OTTAWA COUNTY, MI

Register of Deeds Stamp & File Number

I, Donald W. Schiele, in a field survey on September 13, 19 94, do hereby certify that under requirements of P.A. 74, Michigan P.A. of 1970, the corner points mentioned in lines 1 and 2 above were in conformance with regulations and rules therefore as required in the current manual of survey instructions of the United States Department of the Interior, Bureau of Land Management or by a decree of a Court of Law and/or that the corner points mentioned in lines 3, 4 and 5 above were in conformance with the rules of the Michigan Board of Land Surveyors or by a Decree of a Court of Law; established, re-established, monumented, re-monumented, recovered, found as expressed below:

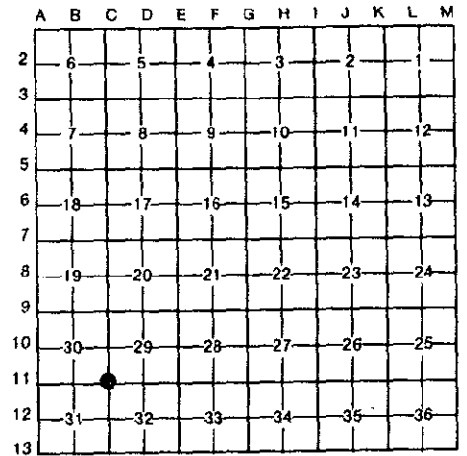

NOTE: Not more than 4 corners, all in the same town and range, may be recorded on this certificate.

A. Description of original monument and accessories and/or subsequent restoration:
C-11 corner common to Section 29, 30, 31 & 32, Polkton Twp.
Original Government L.C.R.C. recorded in Liber 3, Page 267, 8-24-78 3/4" Iron Pipe
Corner Record: of Conc. Culv. ENE 66.10'
Corner post Sec. 29, 30, 31, 32 Q chiselled box on North end
Post of Conc. Culv. ESE 65.50'
Hemlock 18 N34W 03 of Conc. Culv. ESE 65.50'
Beech 6 S34E 03 St. Sign SE 44.00'
John Mullett, Deputy Surveyor Tel. Ped. SW 43.60'
April 14, 1837 Nail in side of Power Pole WNW 184.50'

L.C.R.C. recorded in Liber 4, Page 120, 11-26-80
Set Cast Iron Monument
6" Tree ENE 119.03'
Street Sign SE 44.50'
Telephone Pedestal SW 43.60'

(Also see L.C.R.C. recorded in Liber 3, Page 183, 9-16-77)

B. Description of corner evidence found and/or method applied in restoring or reestablishing corner:
C-11 Found broken Cast Iron Monument 6" below surface in Monument Box and accepted as a careful and faithful perpetuation of the position of the original corner.
Found chiselled box in N. end 12" Concrete Culvert N70°30'E 66.02'
Found "PK" nail in S. side 16" Cottonwood N 77° E 118.96'
Found chiselled cross in S. end 12" Concrete Culvert S69°30'E 65.66'
Centerline Street Sign S 40° E 44.05'
Centerline Telephone Pedestal S41°30'W 43.75'
Found nail in SW side Power Pole N 63° W 184.37'

P.A. 345 OTTAWA COUNTY

PEER APPROVED 9/9/94

Donald W. Schiele

C. Description of monument for corner and accessories established to perpetuate locating the position of the corner:
C-11 Broken Cast Iron Monument 6" below surface in Monument Box.
Set Ottawa County Remon Tag & nail in S. side 16" Cottonwood N 77° E 119.00'
Chiselled cross in S. end 12" Concrete Culvert S69°30'E 65.66'
Set Ottawa County Remon Tag & nail in SE side Telephone Pole S43°30'W 44.56'
Set Ottawa County Remon Tag & nail in SW side Power Pole N 63° W 184.36'
Set Ottawa County Remon Tag & nail in NE side Telephone Pole N 52° W 47.70'
Centerline North & South asphalt road 0.3' East
Centerline asphalt road East 0.4' North
On centerline gravel road West

Signed by Donald W. Schiele
Surveyor's Michigan License No. 23517

Date 9-19-94

