

FEB 24 2000

RECORDED

99 SEP -9 PM 12:15

OTTAWA COUNTY REMONUMENTATION
LAND CORNER RECORDATION CERTIFICATE
Filing Requirement of Act 74, Mich. P.A. 1970

Sam Schiller
REGISTER OF DEEDS
OTTAWA COUNTY, MI

SECTION

For corners in

Ottawa (County)	Located In:	Corner Code #
1. Public Land Survey	T 8N R 14W	C-12 (W $\frac{1}{4}$, 32) Polkton Twp.
	T R	
	T R	
	T R	
2. Property Controlling in Section	S T R	
	S T R	
3. Miscellaneous Property in Sec.	S T R	
	S T R	

Register of Deeds Stamp & File Number

4. Lot No. _____, Recorded Plat _____
5. Private Claims _____

I, Donald W. Schiele, in a field survey on Aug. 24, 1999 do hereby state that under requirements of P.A. 74, Michigan P.A. of 1970, the corner points mentioned in lines 1 and 2 above were in conformance with regulations and rules therefore as required in the current manual of survey instructions of the United States Department of the Interior, Bureau of Land Management or by a decree of a Court of Law and /or that the corner points mentioned in lines 3, 4 and 5 above were in conformance with the rules of the Michigan Board of Land Surveyors or by a Decree of a Court of Law, established, re-established, monumented, recovered, found as expressed below:

NOTE: Not more than 2 corners, all in the same town and range, may be recorded on this certificate.

	A	B	C	D	E	F	G	H	I	J	K	L	M
1													
2		6		5		4		3		2		1	
3													
4		7		8		9		10		11		12	
5													
6		18		17		16		15		14		13	
7													
8		19		20		21		22		23		24	
9													
10		30		29		28		27		26		25	
11													
12		31		32		33		34		35		36	
13													

A. Description of original monument and accessories and/or subsequent restoration:

C-12 1/4 corner common to Sections 31 & 32, Polkton Twp.

Original Government Corner Record:

Set qr section post

Post

B Ash 6 N86W 03

Do N3E 10

John Mullett, Deputy Surveyor

April 14, 1837

L.C.R.C. recorded in L.3, P.183, 9-16-77 by

C.P. Englert, Jr.:

C-12 Set 1/2" Rod on CL Road &

Fence Lines E. & W. (SEE REVERSE)

N.E. 14" Ash 38.18

W. 6" Elm 34.00

S.E. 10" Ash 39.12

B. Description of corner evidence found and/or method applied in restoring or reestablishing corner:

C-12 Found Cast Iron Monument inscribed "Section Corner" in Monument Box, 2 1/2" below surface of asphalt road, and accepted as a careful and faithful perpetuation of the position of the original corner.

Found nail in South side of Quad 9" Elm S84°W 34.04' (E)

South end, 12" Concrete Culvert N23°30'W 64.05' (E)

PAID BY STATE OF MICHIGAN
RECORDED 8/30/99
HDT

C. Description of monument for corner and accessories established to perpetuate locating the position of the corner:

C-12 Cast Iron Monument inscribed "Section Corner" in Monument Box, 2 1/2" below surface of asphalt road.

Set Ottawa County Remon Tag & nail in West side of 36" Maple N03°E 505.86' (E)

Set Ottawa County Remon Tag & nail in South side of 7" Oak S83°E 38.23' (E)

Set Ottawa County Remon Tag & nail in South side of Quad 9" Elm S84°W 33.96' (E)

Set Ottawa County Remon Tag & nail in East side of 15" Poplar N25°W 85.35' (E)

Centerline North & South asphalt road, 1.2' East.

On occupation line ± to East.


Occupation line to West, 3' ± South.

\$11.00 CORNER
Receipt #56820
\$2.00 PHOTO
Receipt #56820

Signed by

Donald W. Schiele

Surveyor's Michigan License No. 23517

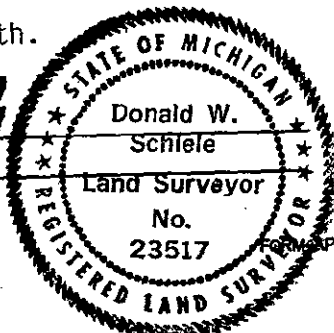

Date August 25, 1999

Part A., continued:

L.C.R.C. recorded in L.6, P.161, 10-11-91 by Thomas E. Joiner:

C-12 (E $\frac{1}{4}$ cor. Sec. 31-8-14)

9" Ash	WSW	34.04'
South end 18" conc. culv.	NW	64.07'
10" poplar	SE	58.30'

RF

FEB 24 2000

SECTION