

SURVEY & REMONUMENTATION

FEB 27 1998

SECTION

OTTAWA COUNTY REMONUMENTATION LAND CORNER RECORDATION CERTIFICATE Filing Requirement of Act 74, Mich. P.A. 1970

For corners in

OTTAWA

(County)

Located In:

Corner Code #

- | | | | |
|------------------------------------|--------------|---------------|-----------------|
| 1. Public Land Survey | T <u>8</u> N | R <u>14</u> W | C-13 SE corner |
| | T | R | Sec. 31 Polkton |
| | T | R | Twp |
| | T | R | |
| 2. Property Controlling in Section | S | T | R |
| | S | T | R |
| 3. Miscellaneous Property in Sec. | S | T | R |
| | S | T | R |

RECORDED
97 DEC -8 AM 11:31

Larry Schellton
REGISTER OF DEEDS
OTTAWA COUNTY, MI

Register of Deeds Stamp & File Number

4. Lot No. _____, Recorded Plat _____
5. Private Claims _____

1	A	B	C	D	E	F	G	H	I	J	K	L	M
2		6		5		4		3		2		1	
3													
4		7		8		9		10		11		12	
5													
6		18		17		16		15		14		13	
7													
8		19		20		21		22		23		24	
9													
10		30		29		28		27		26		25	
11													
12		31		32		33		34		35		36	
13													

I, Randal J. Vugteveen, in a field survey on November 21, 19 97 do hereby state that under requirements of P.A. 74, Michigan P.A. of 1970, the corner points mentioned in lines 1 and 2 above were in conformance with regulations and rules therefore as required in the current manual of survey instructions of the United States Department of the Interior, Bureau of Land Management or by a decree of a Court of Law and /or that the corner points mentioned in lines 3, 4 and 5 above were in conformance with the rules of the Michigan Board of Land Surveyors or by a Decree of a Court of Law; established, re-established, monumented, recovered, found as expressed below:

NOTE: Not more than 2 corners, all in the same town and range, may be recorded on this certificate.

A. Description of original monument and accessories and/or subsequent restoration:

C-13 GLO survey notes 1837 Surveyor John Mullett Set post 8" Beech North 76 deg East 39 links 9" Hemlock North 56 West 45 links	LCRC Liber 6 Page 161 Sept. 13, 1991 Cast iron monument Telephone pole W 33.88 Concrete Culvert SW 27.03 Telephone pole ESE 37.65' 10" Oak SE 90.94'
--	--

B. Description of corner evidence found and/or method applied in restoring or reestablishing corner:


C-13 Found cast iron monument in monument box Found FK washer South side power pole SE 37.60' Found nail South side power pole West 33.84' Found nail South side 10" Oak SE 90.92'	Accepted position of cast iron monument as a careful perpetuation of the position of the original corner
---	--

P.A. 345 OTTAWA COUNTY
PEER APPROVED 12/1/97

C. Description of monument for corner and accessories established to perpetuate locating the position of the corner:

C-13 Cast iron monument

Set Ottawa County Remon tag & nail in North side power pole AZ 110° 37.60'
Set Ottawa County Remon tag & nail in North side power pole AZ 270° 33.93'
Set Ottawa County Remon tag & nail in SW side 10" Oak AZ 151° 90.90'
Set Ottawa County Remon tag & nail in top of 4x4 wood post AZ 54° 39.82'
Set "X" cut in top North end concrete culvert AZ 249° 27.11'
Centerline North-South road East 1.5'
On centerline of fence ROW to West

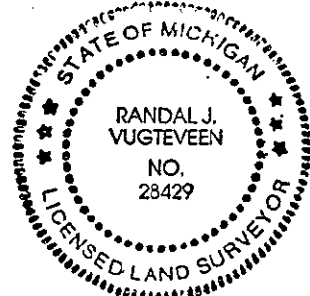

\$ 9.00 CORNER
\$ 1.00 PHOTO

Signed by *Randal J. Vugteveen*
Surveyor's Michigan License No. 28429

Date Dec 1, 1997