

FEB 4 2000

RECORDED

OTTAWA COUNTY REMONUMENTATION 99 DEC -2 PM 1: 14
LAND CORNER RECORDATION CERTIFICATE
Filing Requirement of Act 74, Mich. P.A. 1970

Ann Schiele
REGISTER OF DEEDS
OTTAWA COUNTY, MI

For corners in


<u>Ottawa</u> (County)	Located In:	Corner Code #
1. Public Land Survey	T <u>8N</u> R <u>14W</u>	D-5(N $\frac{1}{4}$, 17) Polkton Twp.
	T <u> </u> R <u> </u>	_____
	T <u> </u> R <u> </u>	_____
	T <u> </u> R <u> </u>	_____
2. Property Controlling in Section	S <u> </u> T <u> </u> R <u> </u>	_____
	S <u> </u> T <u> </u> R <u> </u>	_____
3. Miscellaneous Property in Sec.	S <u> </u> T <u> </u> R <u> </u>	_____
	S <u> </u> T <u> </u> R <u> </u>	_____
4. Lot No. _____, Recorded Plat _____		
5. Private Claims _____		

Register of Deeds Stamp & File Number

I, Donald W. Schiele, in a field survey on 11-12, 1999 do hereby state that under requirements of P.A. 74, Michigan P.A. of 1970, the corner points mentioned in lines 1 and 2 above were in conformance with regulations and rules therefore as required in the current manual of survey instructions of the United States Department of the Interior, Bureau of Land Management or by a decree of a Court of Law and/or that the corner points mentioned in lines 3, 4 and 5 above were in conformance with the rules of the Michigan Board of Land Surveyors or by a Decree of a Court of Law; established, re-established, monumented, recovered, found as expressed below:

NOTE: Not more than 2 corners, all in the same town and range, may be recorded on this certificate.

NOTED OFFICE
FIELD APPROVED 11/15/99
DPN

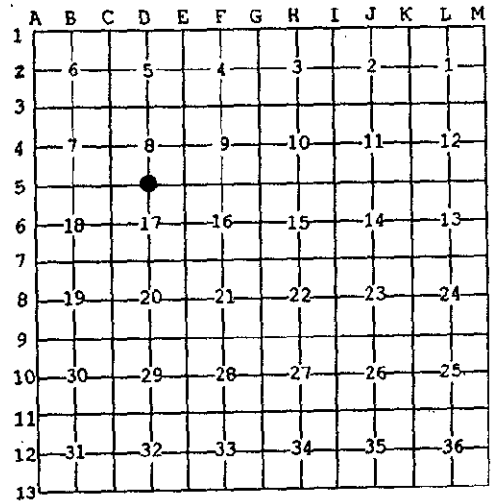

A. Description of original monument and accessories and/or subsequent restoration:

D-5 1/4 corner common to Sections 8 & 17, Polkton Twp.	From unrecorded survey, 6-29-94 by D.W. Schiele:
Original Government Corner Record:	N 1/4 Cor., Sec. 17
Set qr section post	Found Capped Iron #18987
Post	9" Elm E 48.46
Beech 6 N45E. 04	6" Tw. Elm ESE 30.73
Sugar 12 S45W 24	7" Tri. Elm SE 25.73
John Mullett, Deputy Surveyor	7" Tw. Elm SSE 33.22
April 15, 1837	At "X" of occ. lines

B. Description of corner evidence found and/or method applied in restoring or reestablishing corner:

D-5 Found Capped Iron #18987, and accepted as a careful and faithful perpetuation of the position of the original corner.

Found nail & washer in North side of 8" Stump	S89°E	48.46'(E)
Found nail in North side of 6" Twin dead tree	S78°E	30.73'(E)
Found nail & washer in NE side of 8" Triple dead tree	S60°E	25.73'(E)
Found nail & washer in East side of 8" Stump	S10°E	33.22'(E)

C. Description of monument for corner and accessories established to perpetuate locating the position of the corner:


D-5 Removed 5/8" X 16" Capped Iron #18987, and replaced with 3/4" X 36" Steel Bar with Ottawa County Remon Cap.

Set Ottawa County Remon Tag & nail in North side of 5" Elm	S80°30'E	46.48'(E)
Set Ottawa County Remon Tag & nail in SW side of 10" Elm	S55°E	62.86'(E)
Set Ottawa County Remon Tag & nail in SW side of 8" Elm	S45°E	39.73'(E)
Set Ottawa County Remon Tag & nail in West side of 8" Elm	S05°30'E	39.09'(E)

On field line to North.
On fence remnant readings to East. (SEE SKETCH ON REVERSE)
Fence remnant readings to South, 2'± East.

Signed by Donald W. Schiele
Surveyor's Michigan License No. 23517

Date November 15, 1999

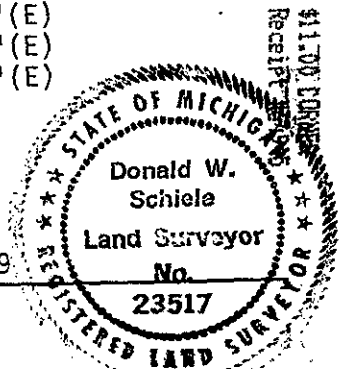

FEB 24 2000

SECTION

