

**SURVEY &
REMONUMENTATION**

APR 24 1995

OTTAWA COUNTY REMONUMENTATION
LAND CORNER RECORDATION CERTIFICATE
Filing Requirement of Act 74, Mich. P.A. 1970

RECORDED

94 DEC 14 AM 9:41

For corners **COMMISSION**

Register of Deeds
REGISTER OF DEEDS
OTTAWA COUNTY, MI

| Ottawa (County) | Located In: | Corner Code # |
|---------------------------------------|--------------------------|---|
| 1. Public Land Survey | T <u>8N</u> R <u>14W</u> | <u>D-7 (N$\frac{1}{4}$, 20)</u> <u>Polkton Twp.</u> |
| | T _____ R _____ | _____ |
| | T _____ R _____ | _____ |
| | T _____ R _____ | _____ |
| 2. Property Controlling in Section | S _____ T _____ R _____ | _____ |
| | S _____ T _____ R _____ | _____ |
| 3. Miscellaneous Property in Sec. | S _____ T _____ R _____ | _____ |
| | S _____ T _____ R _____ | _____ |
| 4. Lot No. _____, Recorded Plat _____ | | |
| 5. Private Claims _____ | | |

Register of Deeds Stamp & File Number

I, Donald W. Schiele, in a field survey on December 10, 19 94, do hereby certify that under requirements of P.A. 74, Michigan P.A. of 1970, the corner points mentioned in lines 1 and 2 above were in conformance with regulations and rules therefore as required in the current manual of survey instructions of the United States Department of the Interior, Bureau of Land Management or by a decree of a Court of Law and/or that the corner points mentioned in lines 3, 4 and 5 above were in conformance with the rules of the Michigan Board of Land Surveyors or by a Decree of a Court of Law; established, re-established, monumented, re-monumented, recovered, found as expressed below:

| | A | B | C | D | E | F | G | H | I | J | K | L | M |
|----|----|----|----|----|----|----|---|---|---|---|---|---|---|
| 2 | 6 | 5 | 4 | 3 | 2 | 1 | | | | | | | |
| 3 | | | | | | | | | | | | | |
| 4 | 7 | 8 | 9 | 10 | 11 | 12 | | | | | | | |
| 5 | | | | | | | | | | | | | |
| 6 | 18 | 17 | 16 | 15 | 14 | 13 | | | | | | | |
| 7 | | | | | | | | | | | | | |
| 8 | 19 | 20 | 21 | 22 | 23 | 24 | | | | | | | |
| 9 | | | | | | | | | | | | | |
| 10 | 30 | 29 | 28 | 27 | 26 | 25 | | | | | | | |
| 11 | | | | | | | | | | | | | |
| 12 | 31 | 32 | 33 | 34 | 35 | 36 | | | | | | | |
| 13 | | | | | | | | | | | | | |

NOTE: Not more than 4 corners, all in the same town and range, may be recorded on this certificate.

A. Description of original monument and accessories and/or subsequent restoration:
D-7 $\frac{1}{4}$ corner common to Sections 17 & 20, Polkton Twp.

| | | |
|--|---|---|
| Original Government Corner Record: | L.C.R.C. recorded in Liber 3, Page 284, 8-29-78 | L.C.R.C. recorded in Liber 4, Page 274, 12-4-81 |
| Set qr section post between Sec. 17 & 20 | Iron Pipe | Set Cast Iron Monument |
| Post | SW corner headwall N81°E 91.40' | C/L Highway N 50.50' |
| Hemlock 35 S22W 35 | Edge pavement N 39.45' | 7" Apple S 26.56' |
| Beech 6 N22E 08 | R/W Marker N 98.55' | 5" Ash SE 28.45' |
| John Mullett, Deputy Surveyor | 3" Ash SE 28.40' | NE Cor. Garage SW 97.60' |
| April 14, 1837 | | |

B. Description of corner evidence found and/or method applied in restoring or reestablishing corner:
D-7 Found Cast Iron Monument inscribed "Section Corner", 1 $\frac{1}{2}$ " below surface, and accepted as a careful and faithful perpetuation of the position of the original corner.


| | | |
|-------------------------------------|-------|--------|
| Centerline Right-Of-Way Marker | N01°E | 98.49' |
| SW corner, Concrete Headwall | N78°E | 91.36' |
| Found nail in SW side of 9" Ash | S42°E | 28.46' |
| Found nail in West side of 8" Apple | South | 26.53' |
| Centerline Cleveland Street | N01°W | 50.5' |
| Edge of pavement | N01°W | 39.5' |

PA. 345 OTTAWA COUNTY
PEER APPROVED 12/12/94

Donald W. Schiele

C. Description of monument for corner and accessories established to perpetuate locating the position of the corner:
D-7 Cast Iron Monument inscribed "Section Corner", 1 $\frac{1}{2}$ " below surface.

| | | |
|---|-------|---------|
| Centerline Right-Of-Way Marker | N01°E | 98.49' |
| Chiselled "X" in West end of Concrete Headwall | N78°E | 91.82' |
| Set Ottawa County Remon Tag & nail in NE side of 9" Ash | S42°E | 28.41' |
| Set Ottawa County Remon Tag & nail in West side of 8" Apple | South | 26.50' |
| NW corner, brick face to House # 8256 | S54°W | 138.68' |
| On occupation line to North, ± | | |
| Fence line to South, 2' East | | |

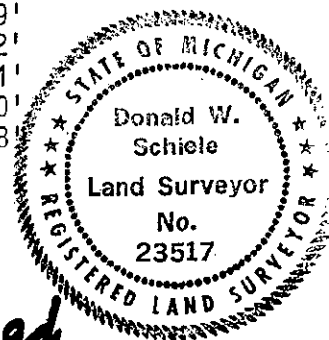

Signed by Donald W. Schiele Date Dec. 12, 1994
Surveyor's Michigan License No. 23517