

SURVEY & REMONUMENTATION

OCT 24 1994

**OTTAWA COUNTY REMONUMENTATION
LAND CORNER RECORDATION CERTIFICATE
Filing Requirement of Act 74, Mich. P.A. 1970**

RECORDED
94 OCT -7 PM 12:32

COMMISSION


For corners in

Debra's Hallman
REGISTER OF DEEDS
OTTAWA COUNTY, MI

<u>Ottawa</u> (County)	Located In:	Corner Code #
1. Public Land Survey	T <u>8N</u> R <u>14W</u>	<u>D-11 (S 1/4, 29)</u> <u>Polkton Twp.</u>
	T _____ R _____	_____
	T _____ R _____	_____
2. Property Controlling in Section	S _____ T _____ R _____	_____
	S _____ T _____ R _____	_____
3. Miscellaneous Property in Sec.	S _____ T _____ R _____	_____
	S _____ T _____ R _____	_____
4. Lot No. _____, Recorded Plat _____		
5. Private Claims _____		

Register of Deeds Stamp & File Number

I, Donald W. Schiele, in a field survey on September 13, 19 94, do hereby certify that under requirements of P.A. 74, Michigan P.A. of 1970, the corner points mentioned in lines 1 and 2 above were in conformance with regulations and rules therefore as required in the current manual of survey instructions of the United States Department of the Interior, Bureau of Land Management or by a decree of a Court of Law and/or that the corner points mentioned in lines 3, 4 and 5 above were in conformance with the rules of the Michigan Board of Land Surveyors or by a Decree of a Court of Law; established, re-established, monumented, re-monumented, recovered, found as expressed below:

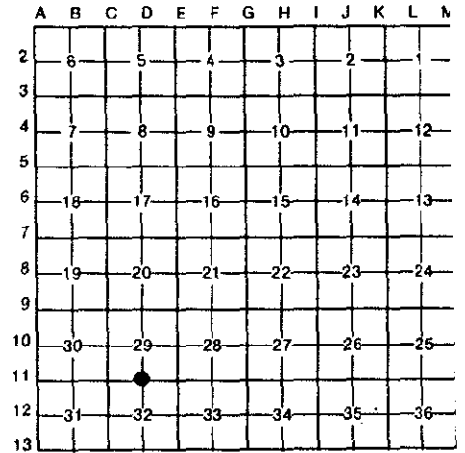

NOTE: Not more than 4 corners, all in the same town and range, may be recorded on this certificate.

A. Description of original monument and accessories and/or subsequent restoration:
D-11 corner common to Sections 29 & 32, Polkton Twp.
Original Government L.C.R.C. recorded in Liber 3, Page 183, 9-16-77
Corner Record: 1" Pipe
Qr section post between sections 29 & 32 N. R.R. Spike in P.P. 33.66'
Post S.W. Cor. F.P. 40.60'
Hemlock 7 S57W 12 S.E. P.P. 50.78'
W Oak 12 N 4E 16
John Mullett, Deputy Surveyor
April 14, 1837

L.C.R.C. recorded in Liber 4, Page 245, 11-4-81
Set Cast Iron Monument
Telephone Pole North 33.66'
Telephone Pole SE 50.72'
St. Sign NNW 31.40'
Cor. Fence Post SW 44.59'


B. Description of corner evidence found and/or method applied in restoring or reestablishing corner:
D-11 Found Cast Iron Monument inscribed "Section Corner" 5" below road surface in Monument Box and accepted as a careful and faithful perpetuation of the position of the original corner.

Found Railroad Spike in S. side of Power Pole	N 03° E	33.57'
Found Nail in E. side of Power Pole	N 03° E	34.12'
Found "PK" nail in NE side of Power Pole	S 40° E	53.60'
Found nail in N. side of Corner Fence Post	S 44° W	48.68'
Centerline Street Sign	N10°30'W	31.48'

P.A. 345 OTTAWA COUNTY
PEER APPROVED 9/19/94

Donald W. Schiele

C. Description of monument for corner and accessories established to perpetuate locating the position of the corner:
D-11 Cast Iron Monument inscribed "Section Corner" 5" below road surface in Monument Box.
Set Ottawa County Remon Tag & nail in E. side of Power Pole N03°E 34.16'
Set Ottawa County Remon Tag & nail in NE side of Power Pole S40°E 53.76'
Set Ottawa County Remon Tag & nail in SE side of 15" Ash S23°W 191.35'
Set Ottawa County Remon Tag & nail in S. side of Telephone Pole N76°W 207.85'
On centerline asphalt roads East, South & West
Power Pole line to North 1.3' East

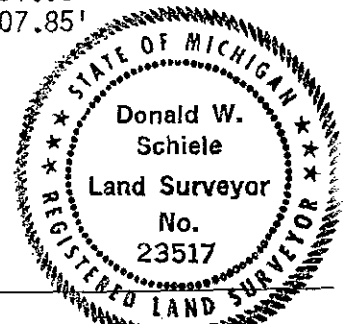

Signed by Donald W. Schiele Date 9-19-94
Surveyor's Michigan License No. 23517