

SURVEY & REMONUMENTATION

FEB 27 1998

OTTAWA COUNTY REMONUMENTATION LAND CORNER RECORDATION CERTIFICATE Filing Requirement of Act 74, Mich. P.A. 1970

For corners in
OTTAWA
(County)

Located In: Corner Code #

- | | | | |
|---------------------------------------|--------------|---------------|--|
| 1. Public Land Survey | T <u>8</u> N | R <u>14</u> W | D-13 (S1/4 corner
Sec.32) Polkton
Twp. |
| | T _____ | R _____ | _____ |
| | T _____ | R _____ | _____ |
| | T _____ | R _____ | _____ |
| 2. Property Controlling
in Section | S _____ | T _____ | R _____ |
| | S _____ | T _____ | R _____ |
| 3. Miscellaneous
Property in Sec. | S _____ | T _____ | R _____ |
| | S _____ | T _____ | R _____ |

RECORDED
97 DEC -8 AM 11:38

[Signature]
REGISTER OF DEEDS
OTTAWA COUNTY, MI

Register of Deeds Stamp & File Number

4. Lot No. _____, Recorded Plat _____
5. Private Claims _____

I, Randal J. Vugteveen, in a field survey on November 21, 1997 do hereby state that under requirements of P.A. 74, Michigan P.A. of 1970, the corner points mentioned in lines 1 and 2 above were in conformance with regulations and rules therefore as required in the current manual of survey instructions of the United States Department of the Interior, Bureau of Land Management or by a decree of a Court of Law and/or that the corner points mentioned in lines 3, 4 and 5 above were in conformance with the rules of the Michigan Board of Land Surveyors or by a Decree of a Court of Law; established, re-established, monumented, recovered, found as expressed below:

NOTE: Not more than 2 corners, all in the same town and range, may be recorded on this certificate.

	A	B	C	D	E	F	G	H	I	J	K	L	M
1													
2	6		5		4		3		2		1		
3													
4	7		8		9		10		11		12		
5													
6	18		17		16		15		14		13		
7													
8	19		20		21		22		23		24		
9													
10	30		29		28		27		26		25		
11													
12	31		32		33		34		35		36		
13													

A. Description of original monument and accessories and/or subsequent restoration:

D-13 G.L.O. survey notes 1837 surveyor John Mullett Set post 9" beech N11°W 37 links 10" beech N22°E 33 links	L.C.R.C. Liber 1 Page 577 7-25-72 iron pipe 24" ash SW 41.51' 30" ash SW 59.32' 12" cherry W 23.38' Power pole SE 48.01'	L.C.R.C. Liber 3 Page 183. 1" pipe 9-3-77 NE telephone pole 46.36' SE power pole 48.35' SW 24" maple 48.78' West 12" cherry 24.06' NOTE:(see back for additional information)
--	---	---


B. Description of corner evidence found and/or method applied in restoring or reestablishing corner:

D-13 Found cast iron monument Found PK SW side power pole SE 48.45' Found PK N side utility pole SW 42.66'	Accepted position of cast Iron monument as a careful perpetuation of the position of the original corner
---	--

P.A. 345 OTTAWA COUNTY
DECEMBER 12 11 1997
[Signature]

C. Description of monument for corner and accessories established to perpetuate locating the position of the corner:

- D-13 Cast iron monument
- Set Ottawa County Remon tag & nail N side 15" Oak AZ 272° 41.99'
 - Set Ottawa County Remon tag & nail SE side utility pole AZ 214° 42.85'
 - Set Ottawa County Remon tag & nail SW side power pole AZ 137° 48.58'
 - Set Ottawa County Remon tag & nail SE side power pole AZ 11° 171.77'
 - On centerline of tree ROW to West
 - At centerline - centerline intersection of roads

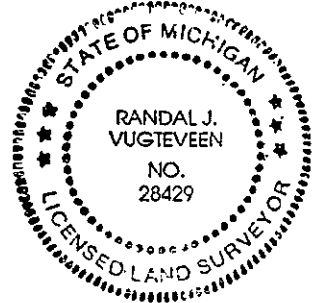

\$ 11.00 CORNER
\$ 2.00 PHOTO

Signed by *[Signature]*
Surveyor's Michigan License No. 28429

Date Dec. 1, 1997

Recorded Survey Records
L.C.R.C. Liber 1, Page 379
July 24, 1972 iron pipe
24" Ash SW 41.31'
30" Ash SW 59.32'
12' Cherry W 23.38'
Power pole SE 48.01'

L.C.R.C. Liber 4, Page 126
D-13
Set cast iron monument
Power pole SE 48.56'
Telephone pole SE 46.27'
22" Maple SW 48.76'
14" Maple NW 57.30'

L.C.R.C. Liber 4, Page 126
D-13
Set cast iron monument

**SURVEY &
REMONUMENTATION**

FEB 27 1998

SECTION